


P.A.DANSIE & ASSOCIATES PTY.LTD.
 A.C.N.008 268 335
LICENSED SURVEYORS
 3 ANGAS STREET PH (08) 86826632
 PORT LINCOLN SA 5606 EMAIL padansie@bigpond.com
 REFERENCE: 02326 FAX (08) 86821466
 ST1 ASCON 7-2008

REV.	DATE	DESCRIPTION	CALC	FIELD
ADDITIONS, AMENDMENTS & APPROVALS				

POINT BOSTON PENINSULA
 AS CONSTRUCTED INFRASTRUCTURE
 SULLIVAN DRIVE

SCALE 0 100 200 400 600 800 1000 METRES

ISSUE DATE 28th JULY 2008

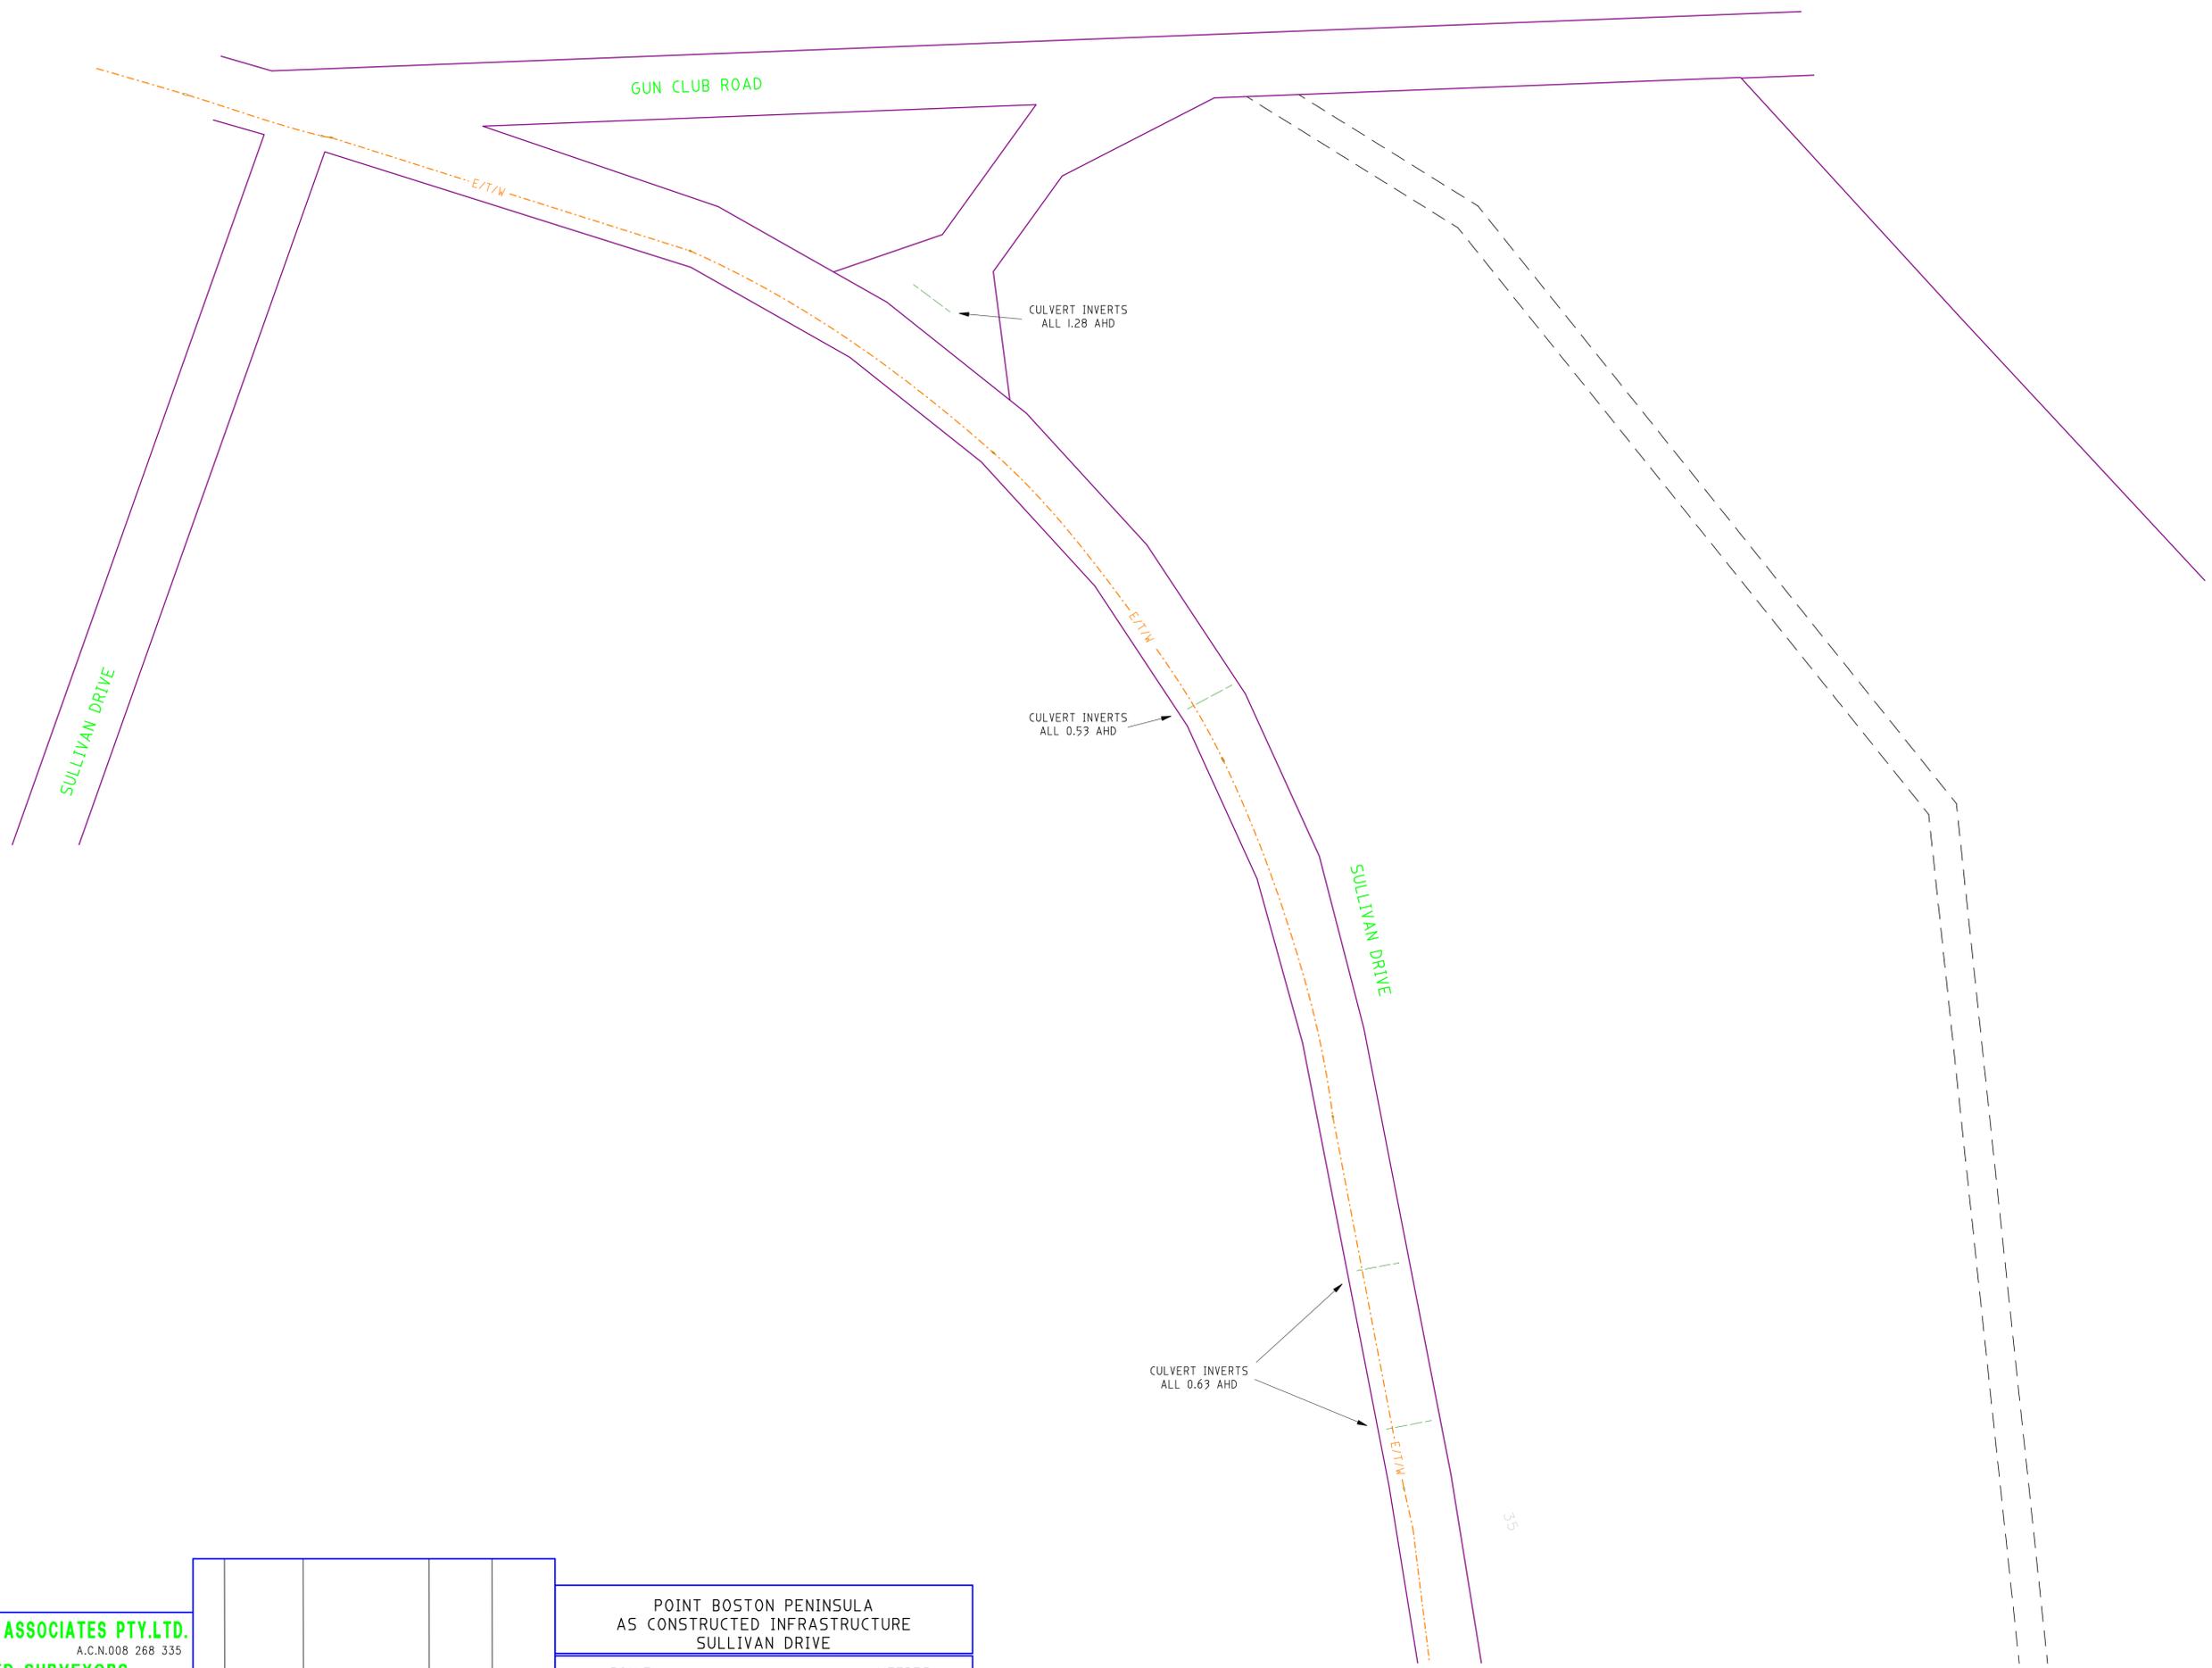

P.A.DANSIE & ASSOCIATES PTY.LTD.


A.C.N.008 268 335
LICENSED SURVEYORS
3 ANGAS STREET PH (08) 86826632
PORT LINCOLN SA 5606 EMAIL padansie@bigpond.com
REFERENCE: 02326 FAX (08) 86821466
ST1 ASCON 7-2008

REV.	DATE	DESCRIPTION	CALC	FIELD
ADDITIONS, AMENDMENTS & APPROVALS				

POINT BOSTON PENINSULA
AS CONSTRUCTED INFRASTRUCTURE
SULLIVAN DRIVE

SCALE 0 10 20 40 60 80 100 METRES

ISSUE DATE 28th JULY 2008

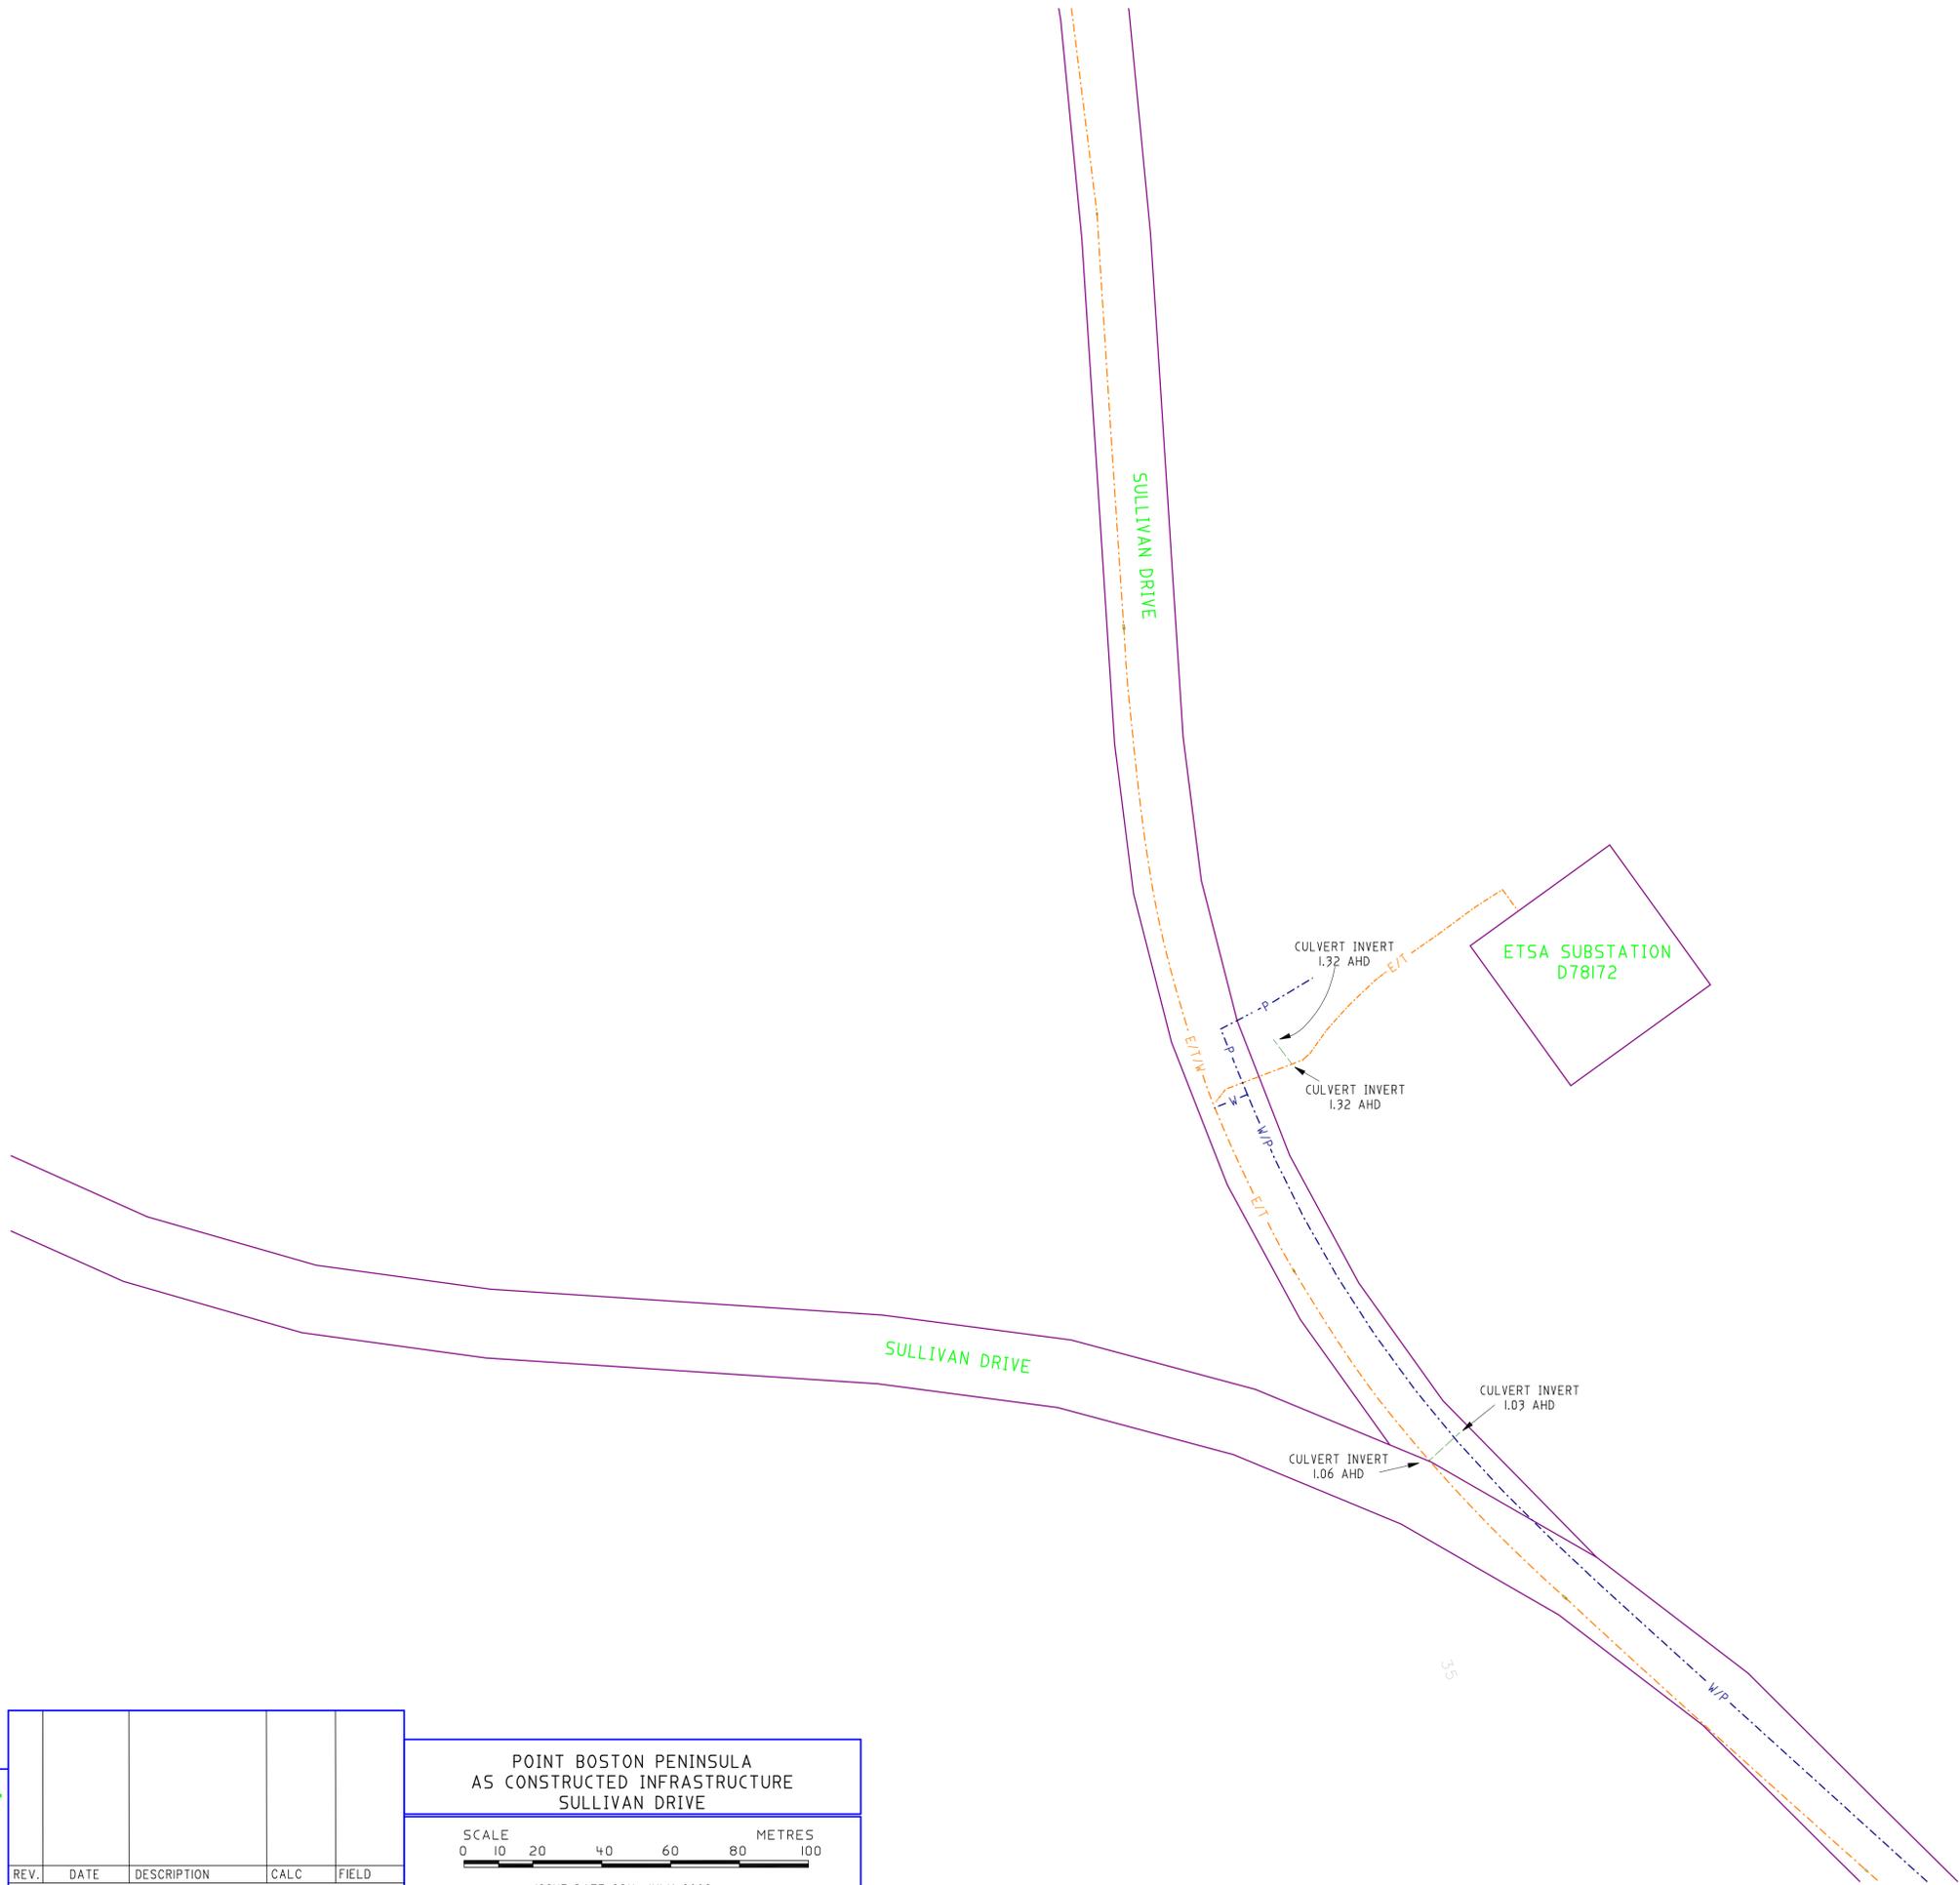

P.A.DANSIE & ASSOCIATES PTY.LTD.
 A.C.N.008 268 335
LICENSED SURVEYORS
 3 ANGAS STREET
 PORT LINCOLN SA 5606
 REFERENCE: 02326
 ST1 ASCON 7-2008



PH (08) 86826632
 EMAIL padansie@bigpond.com
 FAX (08) 86821466

REV.	DATE	DESCRIPTION	CALC	FIELD

POINT BOSTON PENINSULA
 AS CONSTRUCTED INFRASTRUCTURE
 SULLIVAN DRIVE

SCALE 0 10 20 40 60 80 100 METRES

ISSUE DATE 28th JULY 2008

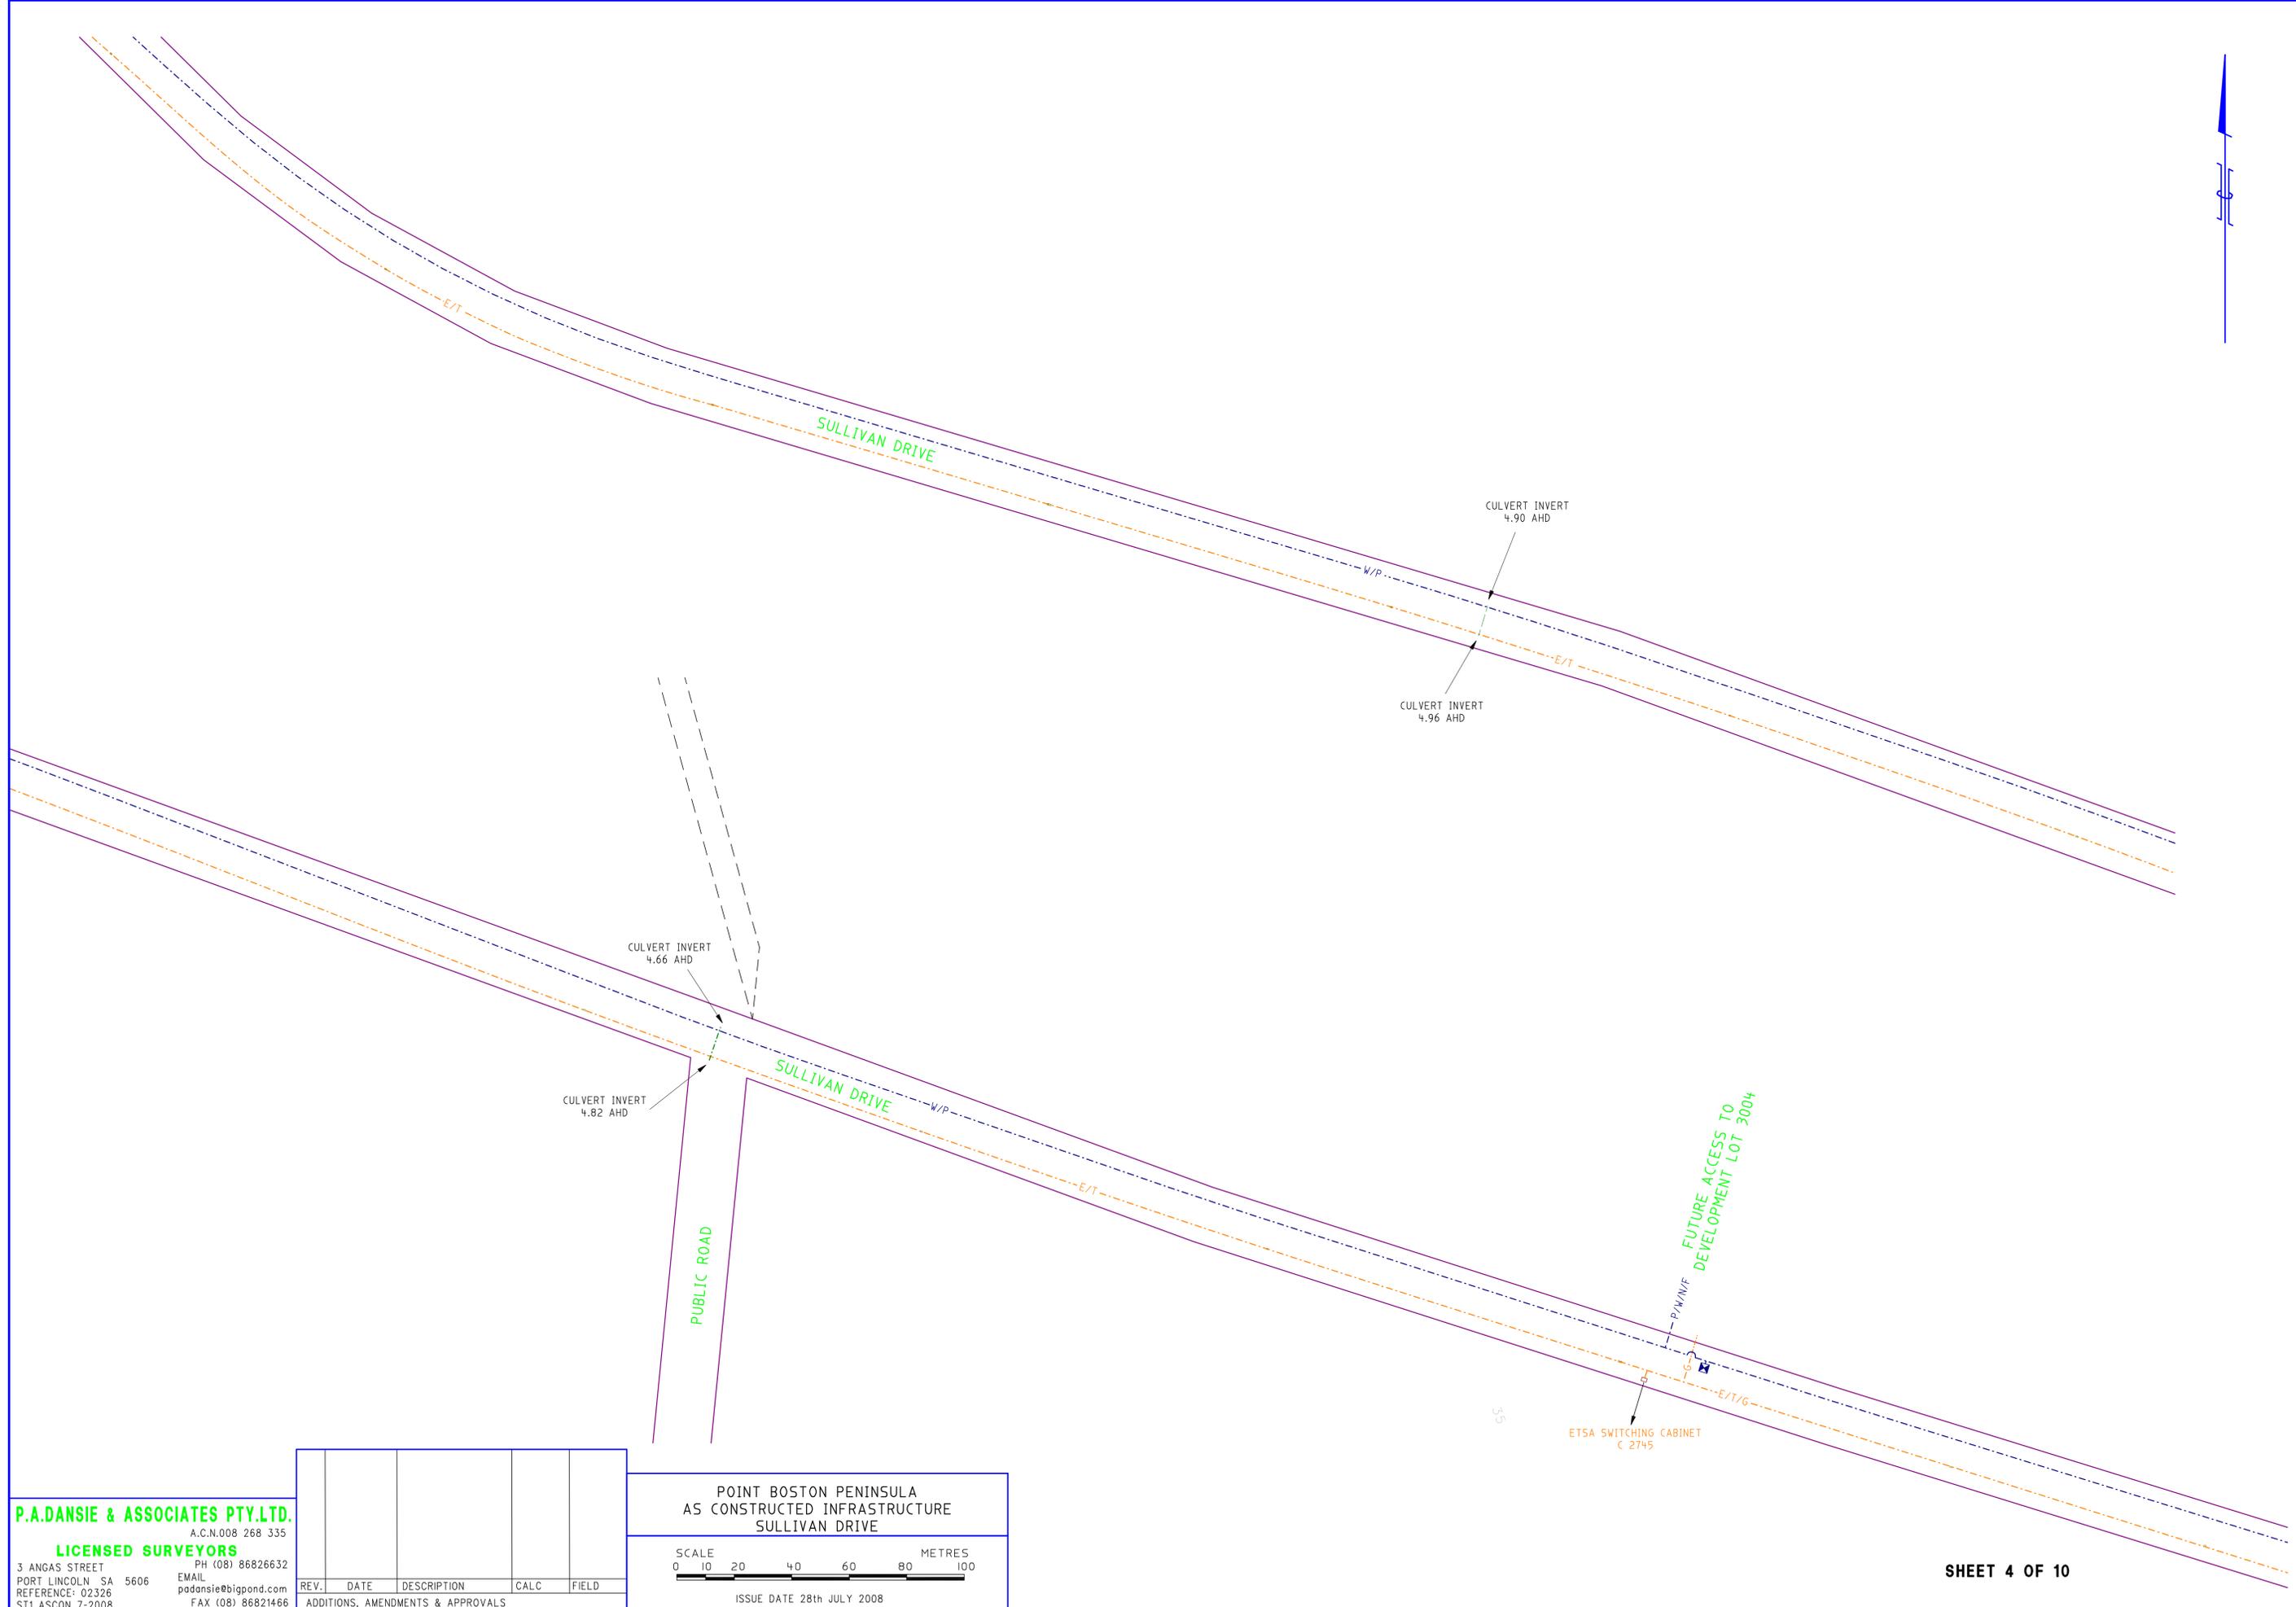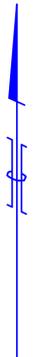




P.A.DANSIE & ASSOCIATES PTY.LTD.
 A.C.N.008 268 335
LICENSED SURVEYORS
 3 ANGAS STREET
 PORT LINCOLN SA 5606
 REFERENCE: 02326
 ST1 ASCON 7-2008

REV.	DATE	DESCRIPTION	CALC	FIELD
ADDITIONS, AMENDMENTS & APPROVALS				

POINT BOSTON PENINSULA
 AS CONSTRUCTED INFRASTRUCTURE
 SULLIVAN DRIVE

SCALE
 0 10 20 40 60 80 100 METRES

ISSUE DATE 28th JULY 2008

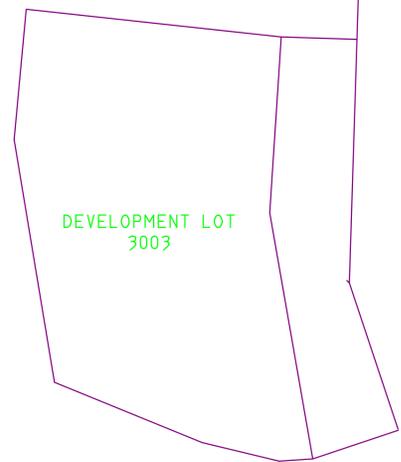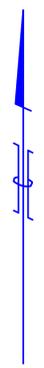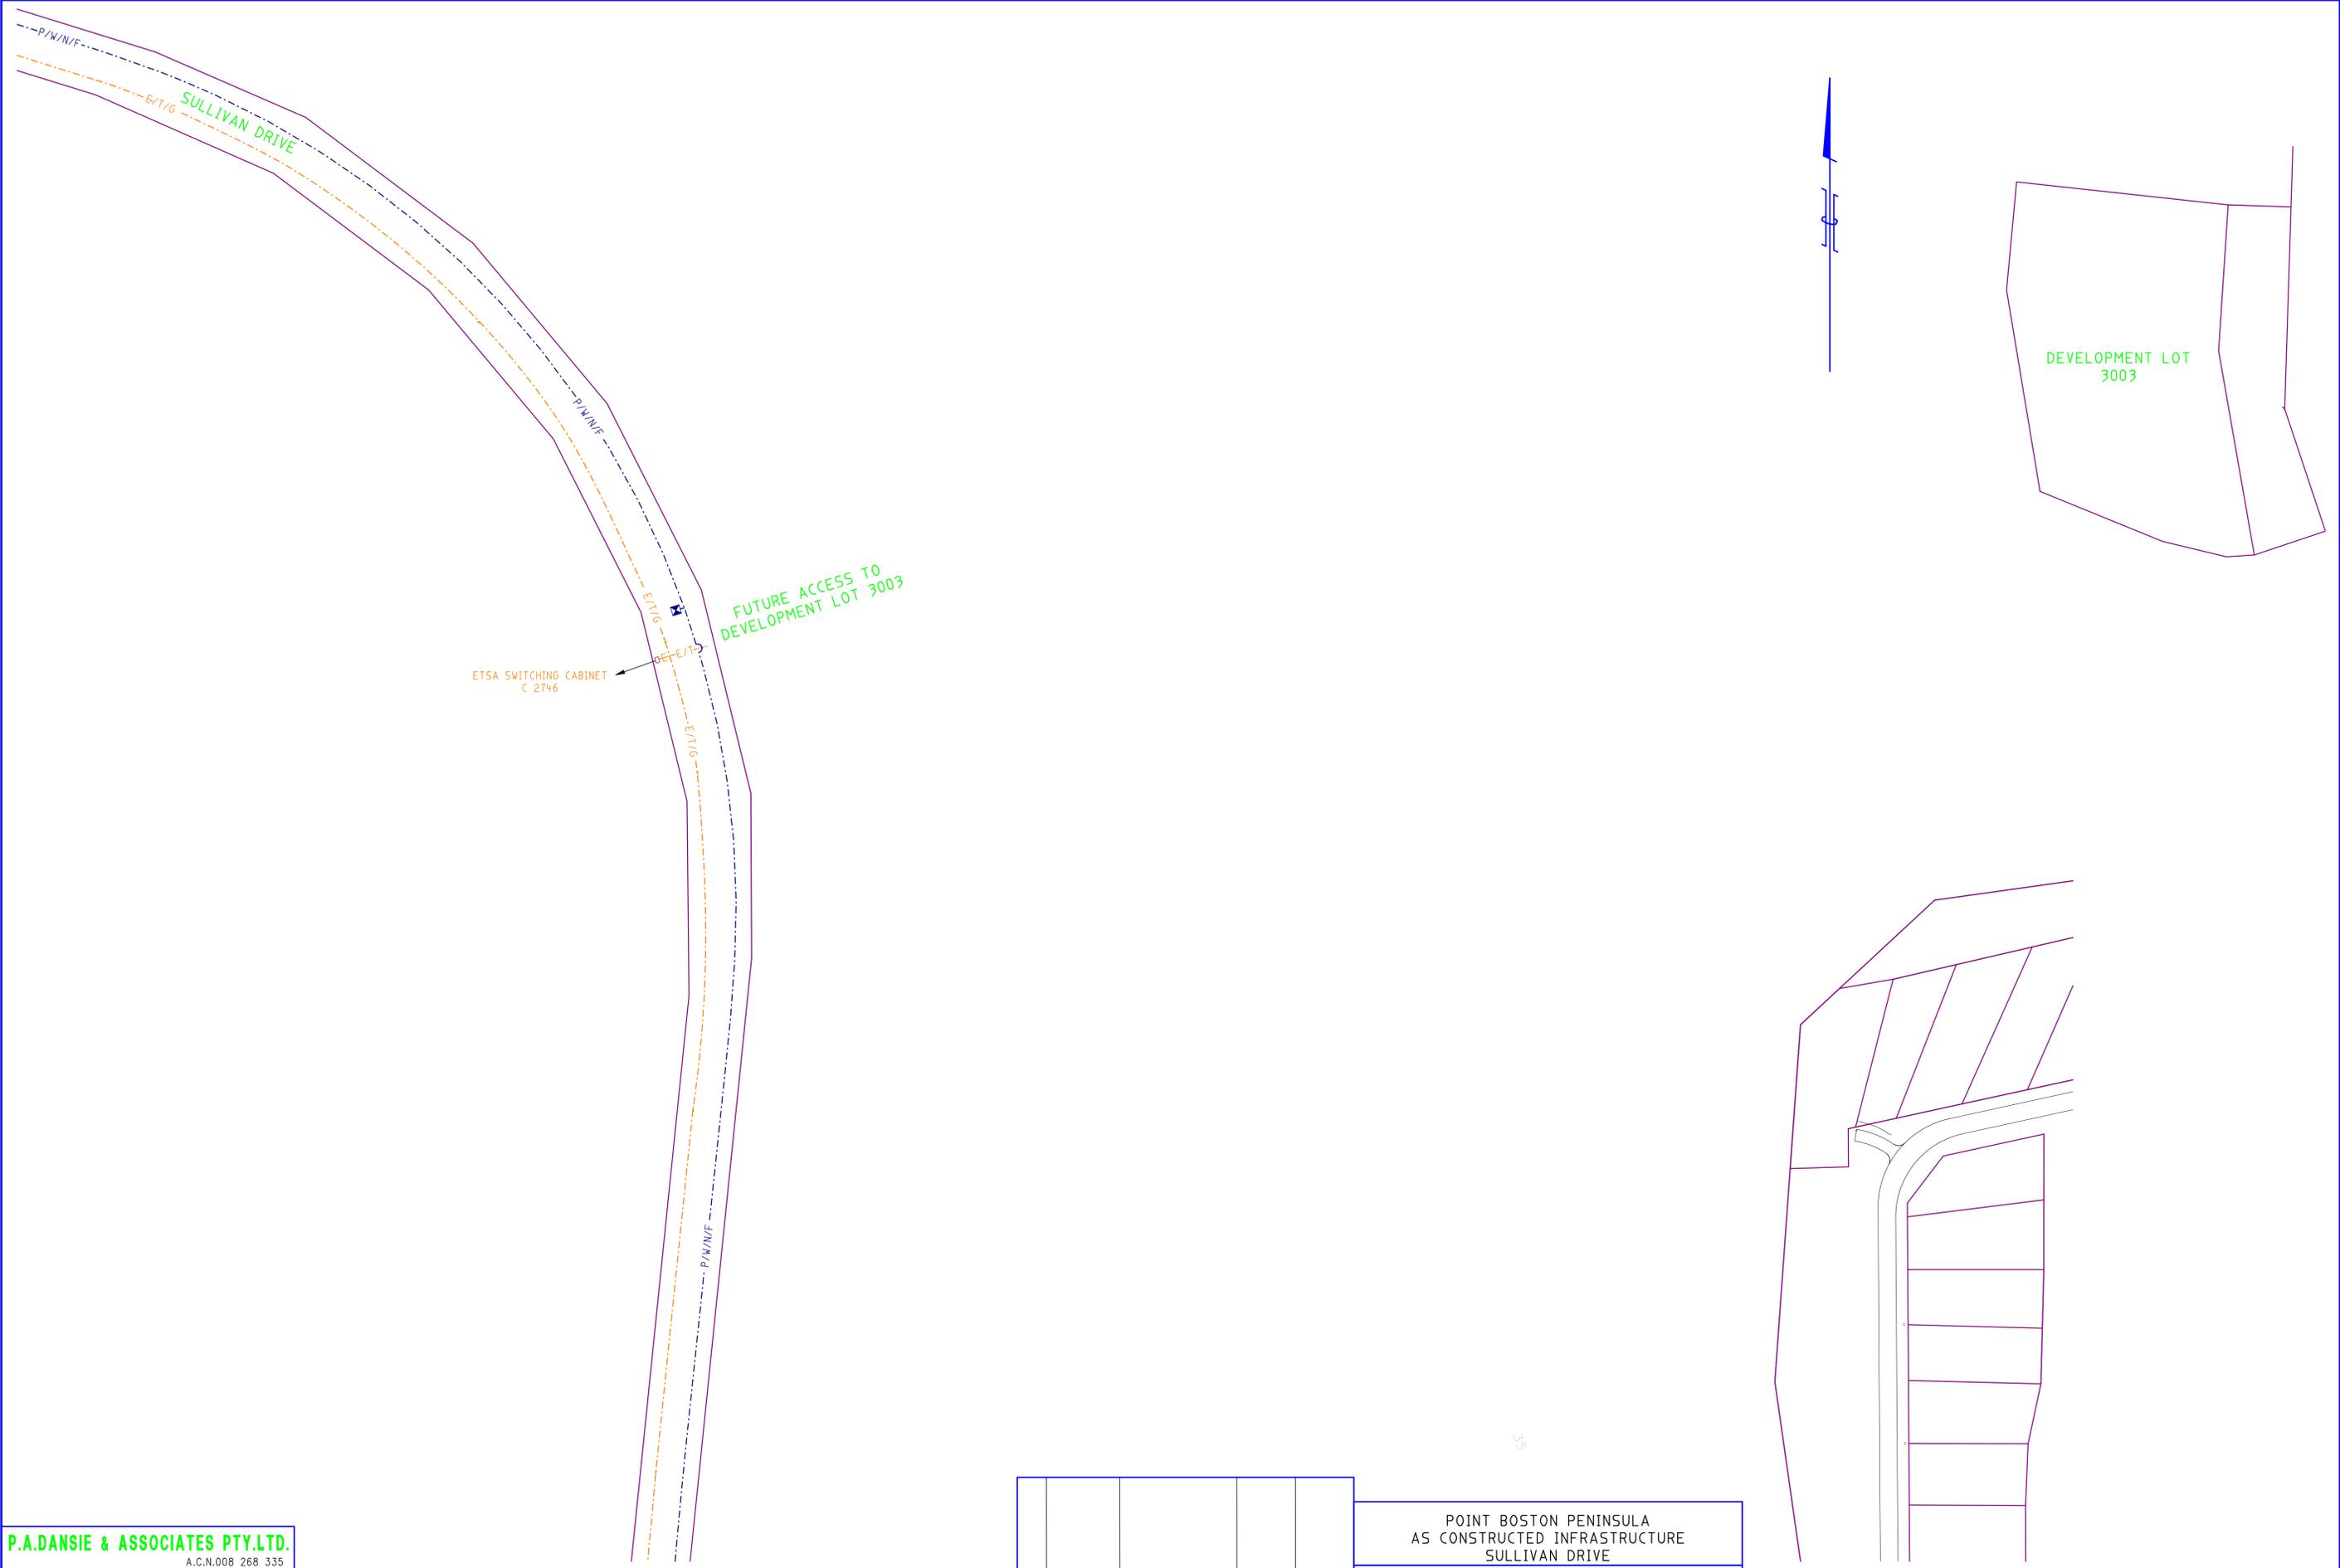



P.A.DANSIE & ASSOCIATES PTY.LTD.
 A.C.N.008 268 335
LICENSED SURVEYORS
 3 ANGAS STREET PH (08) 86826632
 PORT LINCOLN SA 5606 EMAIL padansie@bigpond.com
 REFERENCE: 02326 ST1 ASCON 7-2008 FAX (08) 86821466

REV.	DATE	DESCRIPTION	CALC	FIELD
ADDITIONS, AMENDMENTS & APPROVALS				


POINT BOSTON PENINSULA
 AS CONSTRUCTED INFRASTRUCTURE
 SULLIVAN DRIVE

SCALE
 0 10 20 40 60 80 100 METRES

ISSUE DATE 28th JULY 2008

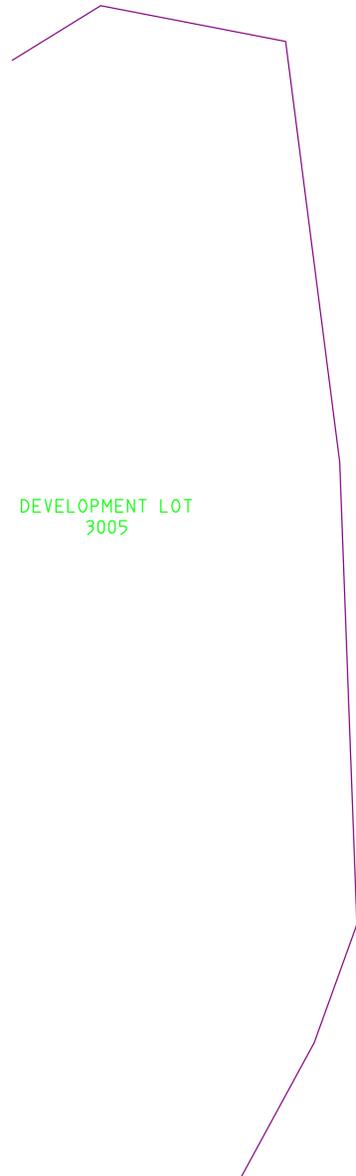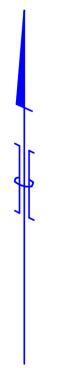

DEVELOPMENT LOT
3005

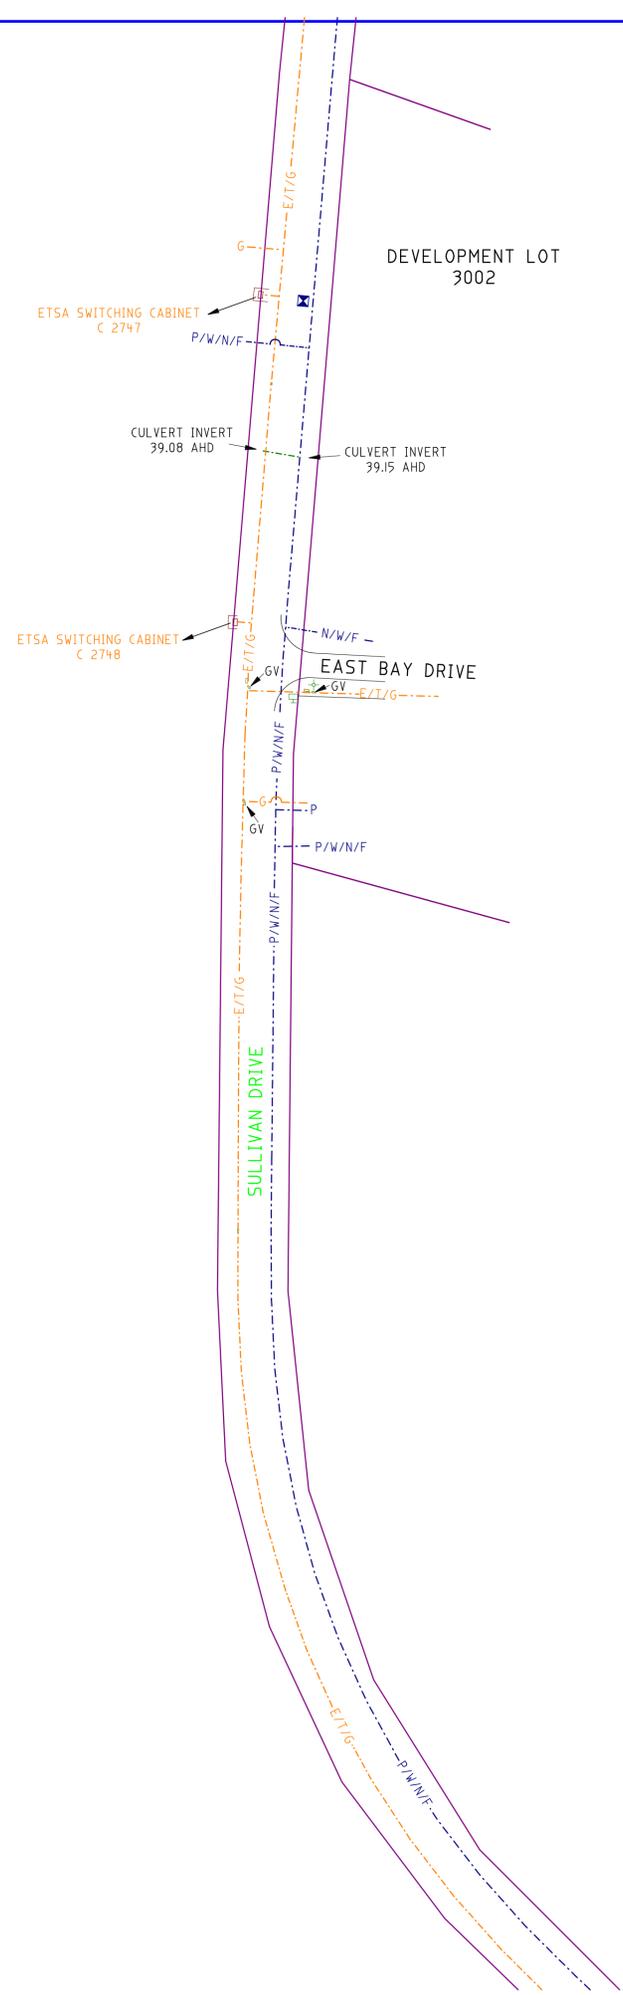

DEVELOPMENT LOT
3002

ETSA SWITCHING CABINET
C 2747

CULVERT INVERT
39.08 AHD

CULVERT INVERT
39.15 AHD

ETSA SWITCHING CABINET
C 2748

EAST BAY DRIVE

SULLIVAN DRIVE



P.A.DANSIE & ASSOCIATES PTY.LTD.
A.C.N.008 268 335
LICENSED SURVEYORS
3 ANGAS STREET
PORT LINCOLN SA 5606
REFERENCE: 02326
ST1 ASCON 7-2008
PH (08) 86826632
EMAIL: podansie@bigpond.com
FAX (08) 86821466

REV.	DATE	DESCRIPTION	CALC	FIELD
ADDITIONS, AMENDMENTS & APPROVALS				

POINT BOSTON PENINSULA
AS CONSTRUCTED INFRASTRUCTURE
SULLIVAN DRIVE

SCALE
0 10 20 40 60 80 100 METRES

ISSUE DATE 28th JULY 2008

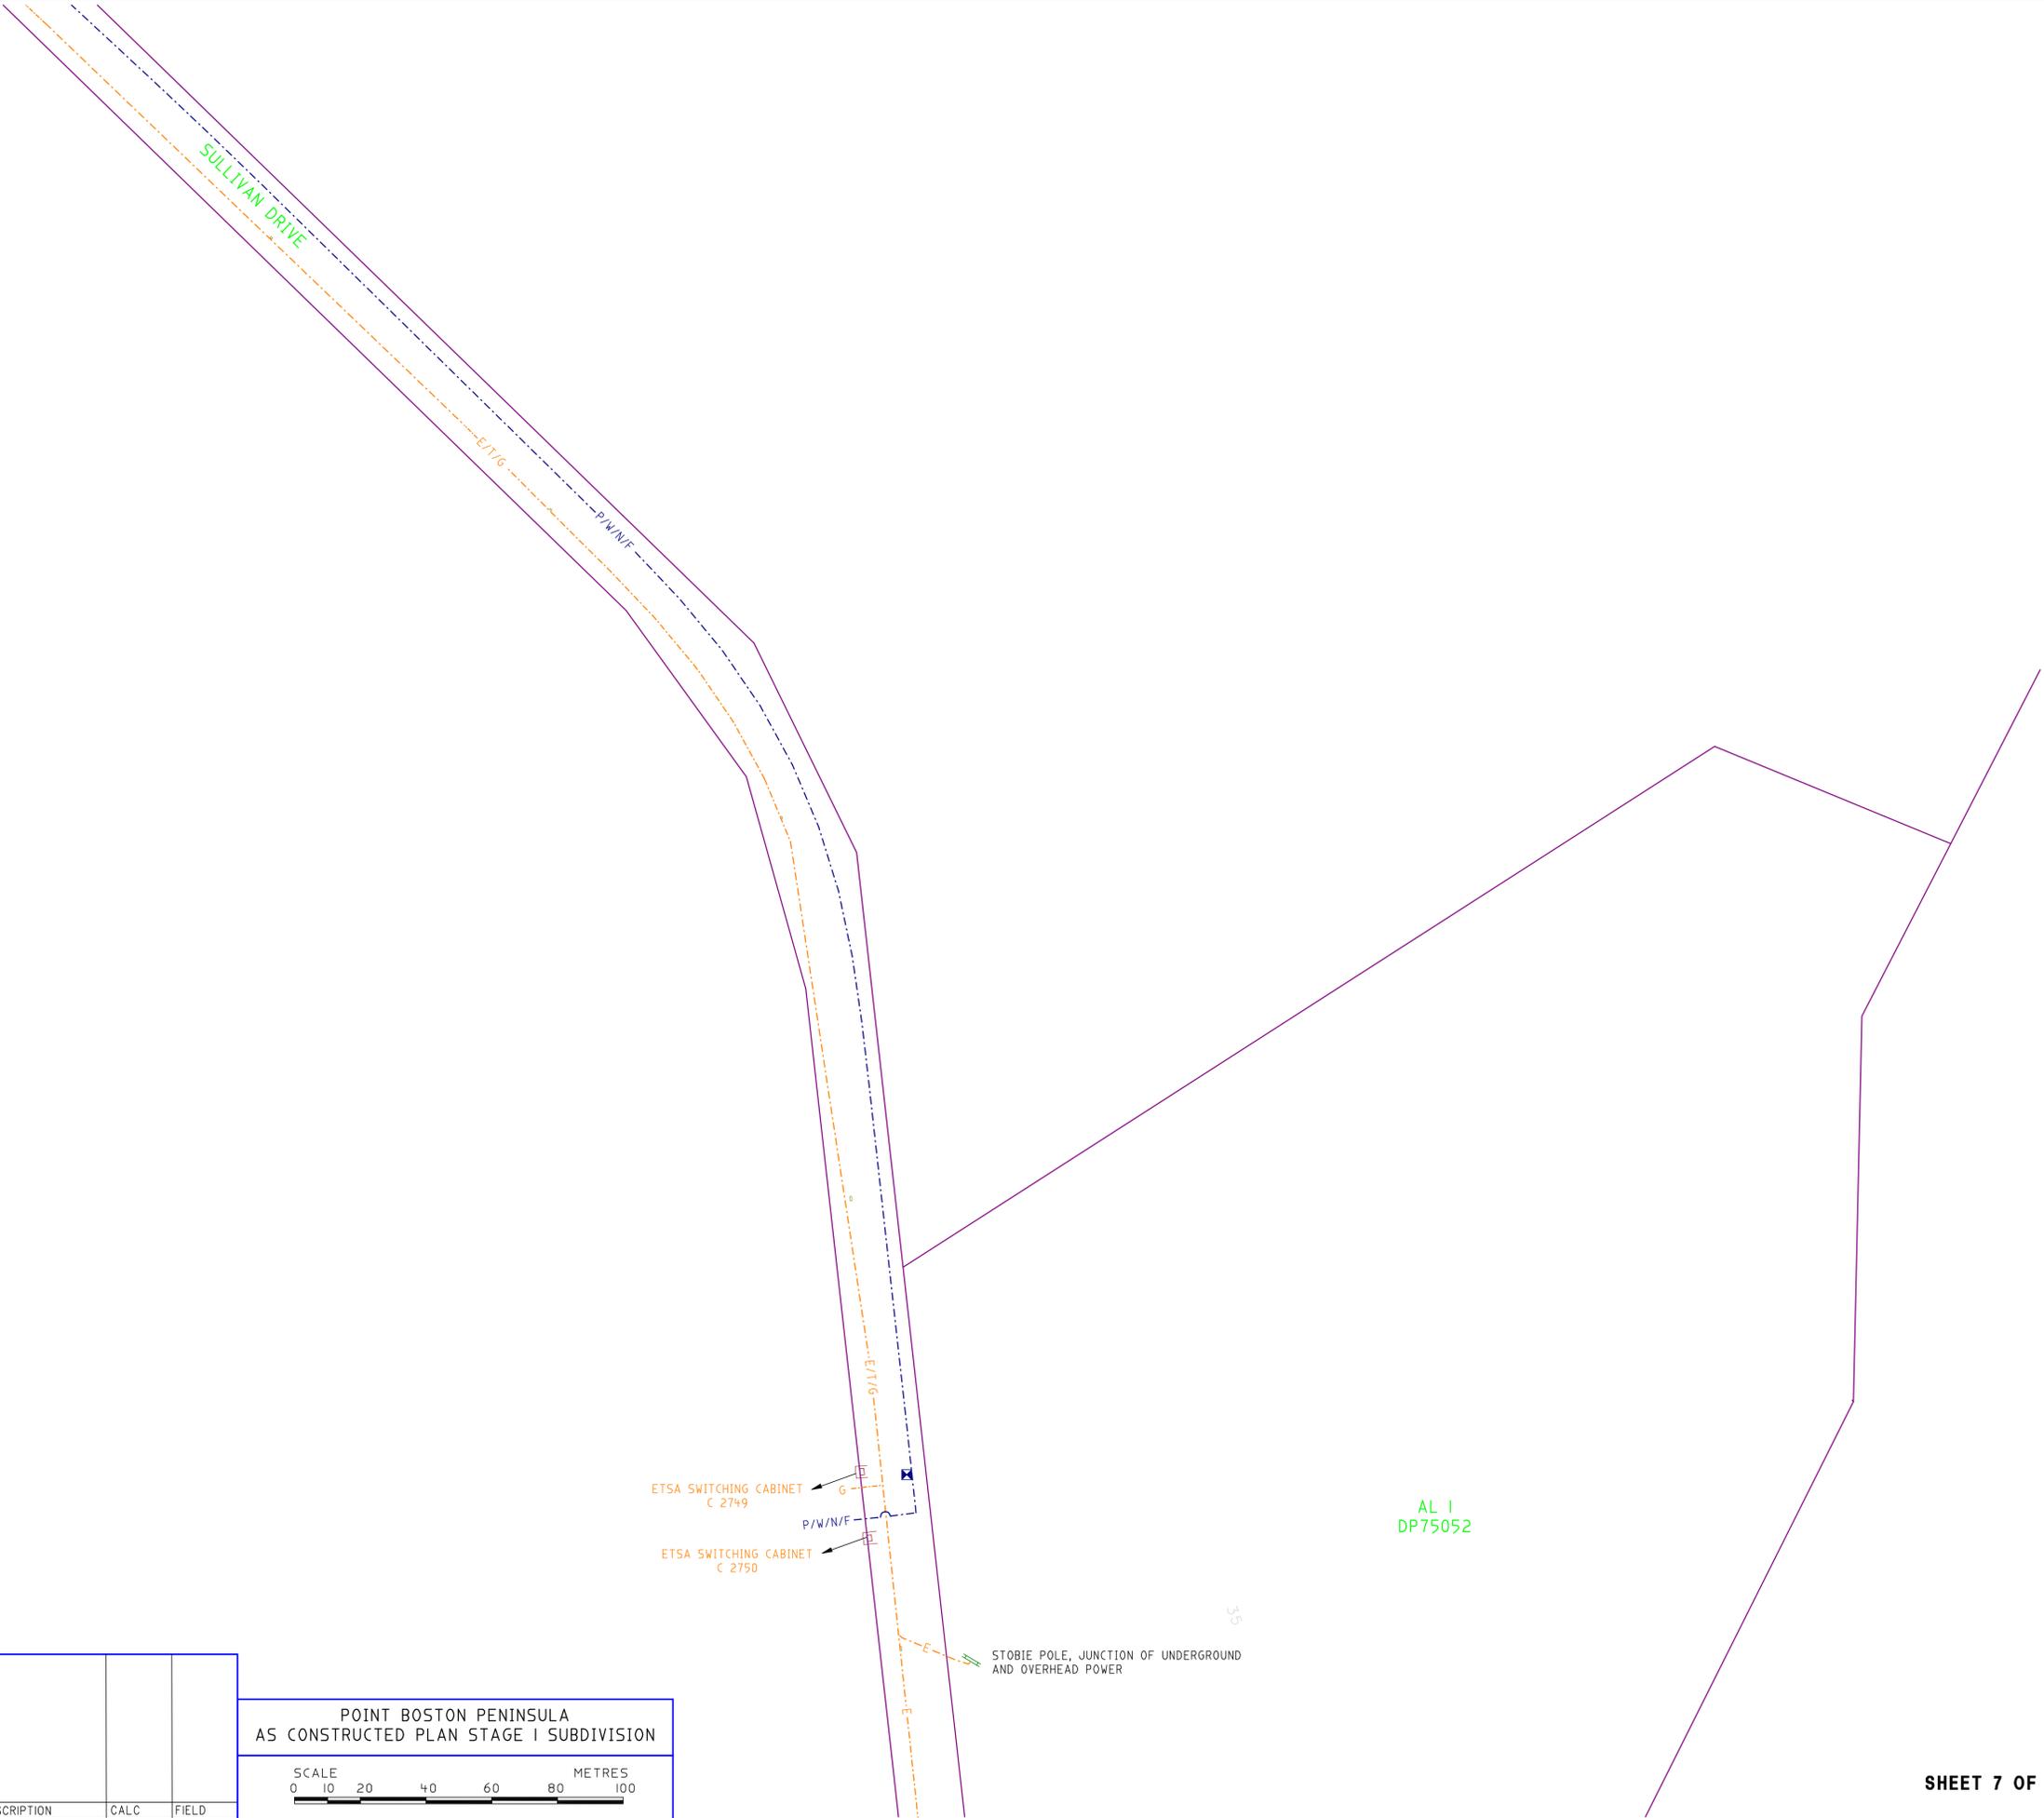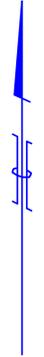

P.A.DANSIE & ASSOCIATES PTY.LTD.
 A.C.N.008 268 335
LICENSED SURVEYORS
 3 ANGAS STREET PORT LINCOLN | SA 5606
 PH (08) 86826632
 EMAIL padansie@bigpond.com
 ST1 ASCON 7-2008 FAX (08) 86821466

REV.	DATE	DESCRIPTION	CALC	FIELD
ADDITIONS, AMENDMENTS & APPROVALS				

POINT BOSTON PENINSULA
 AS CONSTRUCTED PLAN STAGE I SUBDIVISION
 SCALE 0 10 20 40 60 80 100 METRES
 ISSUE DATE 28th JULY 2008

ETSA SWITCHING CABINET C 2749
 P/W/N/F
 ETSA SWITCHING CABINET C 2750
 STOBIE POLE, JUNCTION OF UNDERGROUND AND OVERHEAD POWER

AL 1
 DP75052



CULVERT INVERT 12.88 AHD
CULVERT INVERT 12.77 AHD

AL 1
DP75052

DEVELOPMENT LOT
3006

RESERVE

AL 2
DP75052

STOBIE POLE, JUNCTION OF UNDERGROUND
AND OVERHEAD POWER

55

P.A.DANSIE & ASSOCIATES PTY.LTD.
A.C.N.008 268 335
LICENSED SURVEYORS
3 ANGAS STREET PH (08) 86826632
PORT LINCOLN SA 5606 EMAIL podansie@bigpond.com
REFERENCE: 02326 FAX (08) 86821466
ST11 ASCON 7-2008

REV.	DATE	DESCRIPTION	CALC	FIELD
ADDITIONS, AMENDMENTS & APPROVALS				

POINT BOSTON PENINSULA
AS CONSTRUCTED INFRASTRUCTURE
SULLIVAN DRIVE
SCALE 0 10 20 40 60 80 100 METRES
ISSUE DATE 28th JULY 2008



AL 2
DP75052

CULVERT INVERT
22.31 AHD

CULVERT INVERT
22.38 AHD

CULVERT INVERT
21.43 AHD

CULVERT INVERT
21.37 AHD

3.5


P.A.DANSIE & ASSOCIATES PTY.LTD.
A.C.N.008 268 335
LICENSED SURVEYORS
3 ANGAS STREET 5606 PH (08) 86826632
PORT LINCOLN SA 5606 EMAIL pdansie@bigpond.com
REFERENCE: 02326 FAX (08) 86821466
ST1 ASCON 7-2008

REV.	DATE	DESCRIPTION	CALC	FIELD
ADDITIONS, AMENDMENTS & APPROVALS				

POINT BOSTON PENINSULA
AS CONSTRUCTED INFRASTRUCTURE
SULLIVAN DRIVE

SCALE 0 10 20 40 60 80 100 METRES

ISSUE DATE 28th JULY 2008

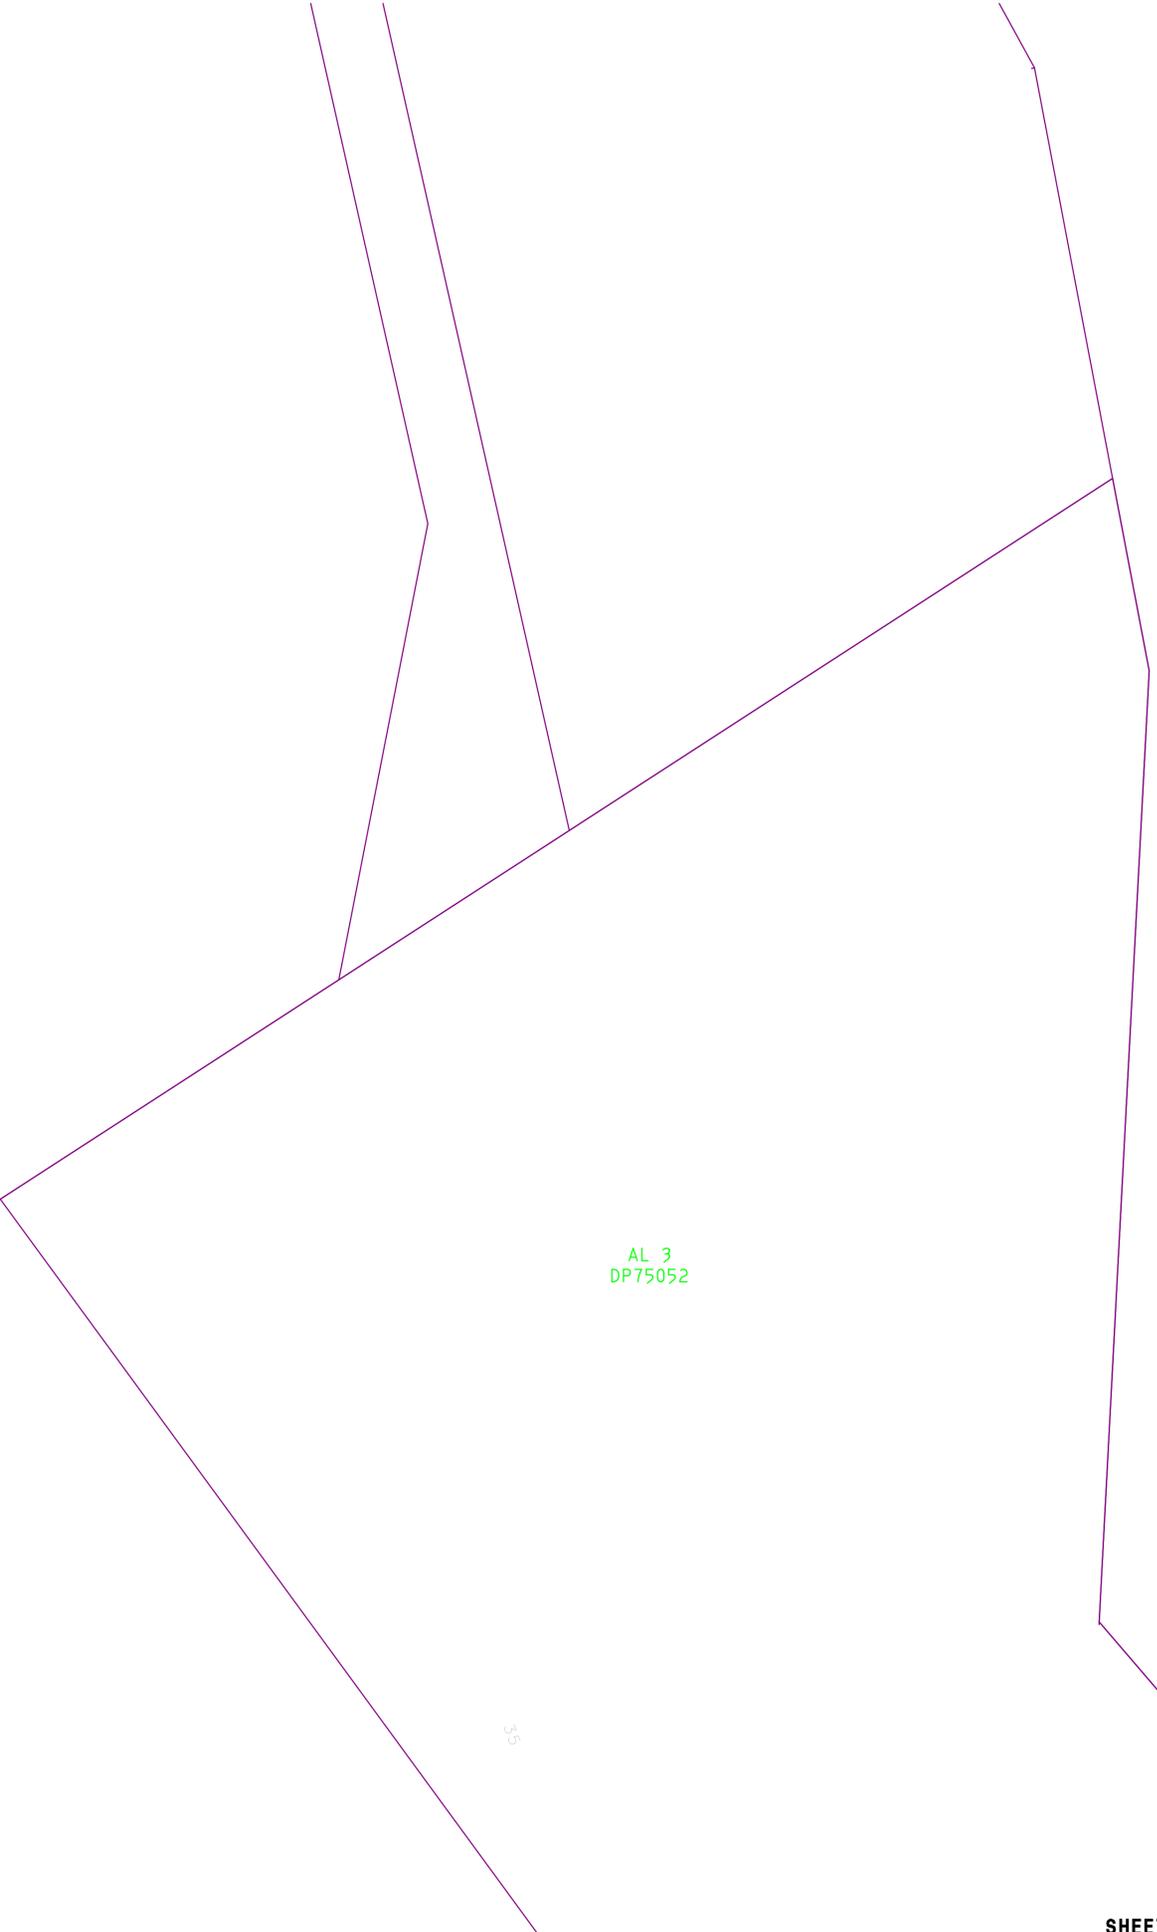

AL 3
DP75052

35

P.A.DANSIE & ASSOCIATES PTY.LTD.
A.C.N.008 268 335
LICENSED SURVEYORS
3 ANGAS STREET PH (08) 86826632
PORT LINCOLN SA 5606 EMAIL podansie@bigpond.com
REFERENCE: 02326 ST1 ASCON 7-2008 FAX (08) 86821466

REV.	DATE	DESCRIPTION	CALC	FIELD
ADDITIONS, AMENDMENTS & APPROVALS				

POINT BOSTON PENINSULA
AS CONSTRUCTED INFRASTRUCTURE
SULLIVAN DRIVE

SCALE 0 10 20 40 60 80 100 METRES

ISSUE DATE 28th JULY 2008