


LEGEND

B DENOTES BROADBAND CABLE	□ DENOTES DRINKING WATER, NON DRINKING WATER & GAS CONNECTION
D DENOTES STORMWATER DRAINAGE	○ FV DENOTES FLUSH POINT VALVE IN GROUND BOX ON NDW & DW SERVICES
E DENOTES ELECTRICITY PURPOSES	□ DENOTES EFFLUENT CONNECTION
F DENOTES FIRE SERVICE RETICULATION	○ DENOTES COMMUNICATIONS POLE
G DENOTES GAS SUPPLY/RETICULATION	GV DENOTES GAS VALVE
N DENOTES NON DRINKING WATER	AV DENOTES AIR RELEASE VALVE ON PUMPED EFFLUENT LINE
P DENOTES PUMPED EFFLUENT RETICULATION	⊠ DENOTES FIRE PLUG
T DENOTES TELEPHONE SYSTEM	⊠ DENOTES STOP VALVE
W DENOTES WATER SUPPLY/RETICULATION	⊠ DENOTES STREET LIGHT
/ DENOTES SERVICES IN SAME TRENCH	⊠ DENOTES STREET SIGN POST
○ DENOTES SERVICES CROSS OVER	□ DENOTES T/F 46261 DENOTES TRANSFORMER AND CABINET NUMBER
	⊠ DENOTES POWER SUPPLY POINT TO LOTS
	⊠ DENOTES TELSTRA PIT
	⊠ DENOTES ELECTRICITY PIT

PIPE INVERT RL 38.24  
 STORMWATER DRAINAGE REDUCED LEVELS (RL) DATUM IS AHD


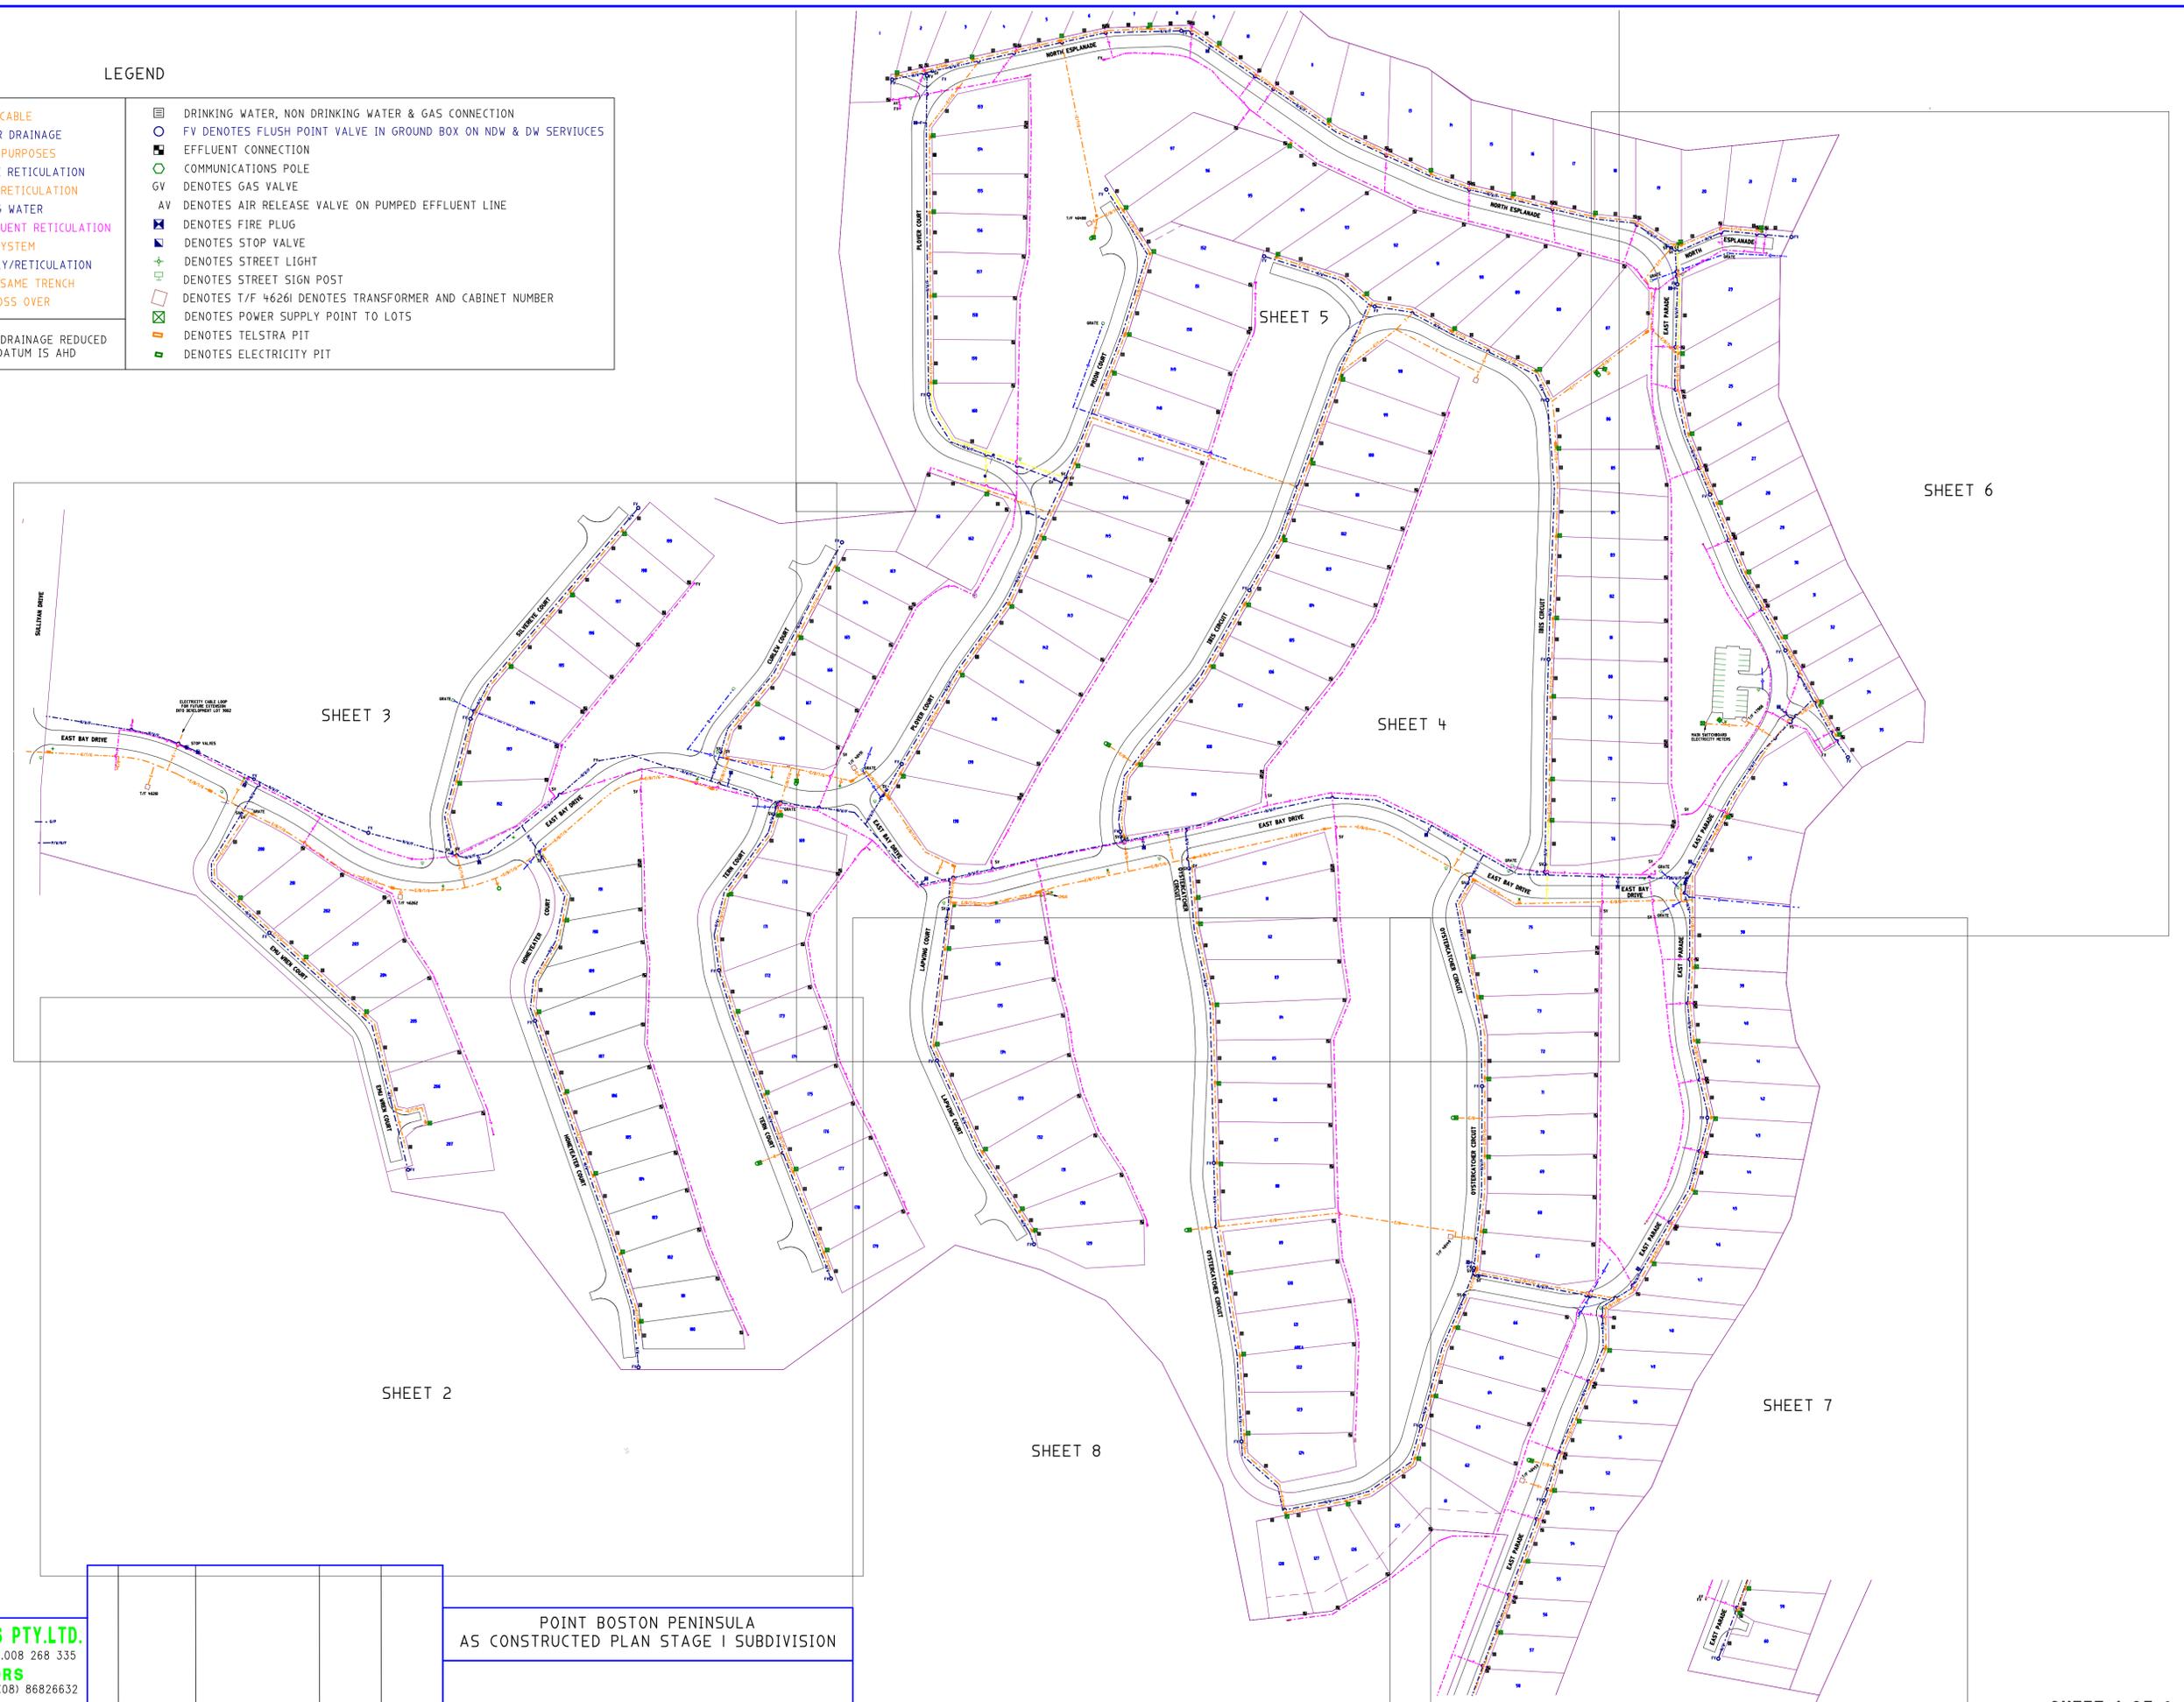


**P.A.DANSIE & ASSOCIATES PTY.LTD.**  
 A.C.N.008 268 335  
**LICENSED SURVEYORS**  
 3 ANGAS STREET PH (08) 86826632  
 PORT LINCOLN SA 5606 EMAIL padansie@bigpond.com  
 REFERENCE: 02326 FAX (08) 86821466  
 ST1 ASCON 7-2008

REV.	DATE	DESCRIPTION	CALC	FIELD

POINT BOSTON PENINSULA  
 AS CONSTRUCTED PLAN STAGE I SUBDIVISION



ISSUE DATE 28th JULY 2008

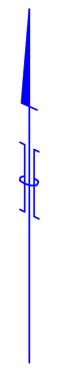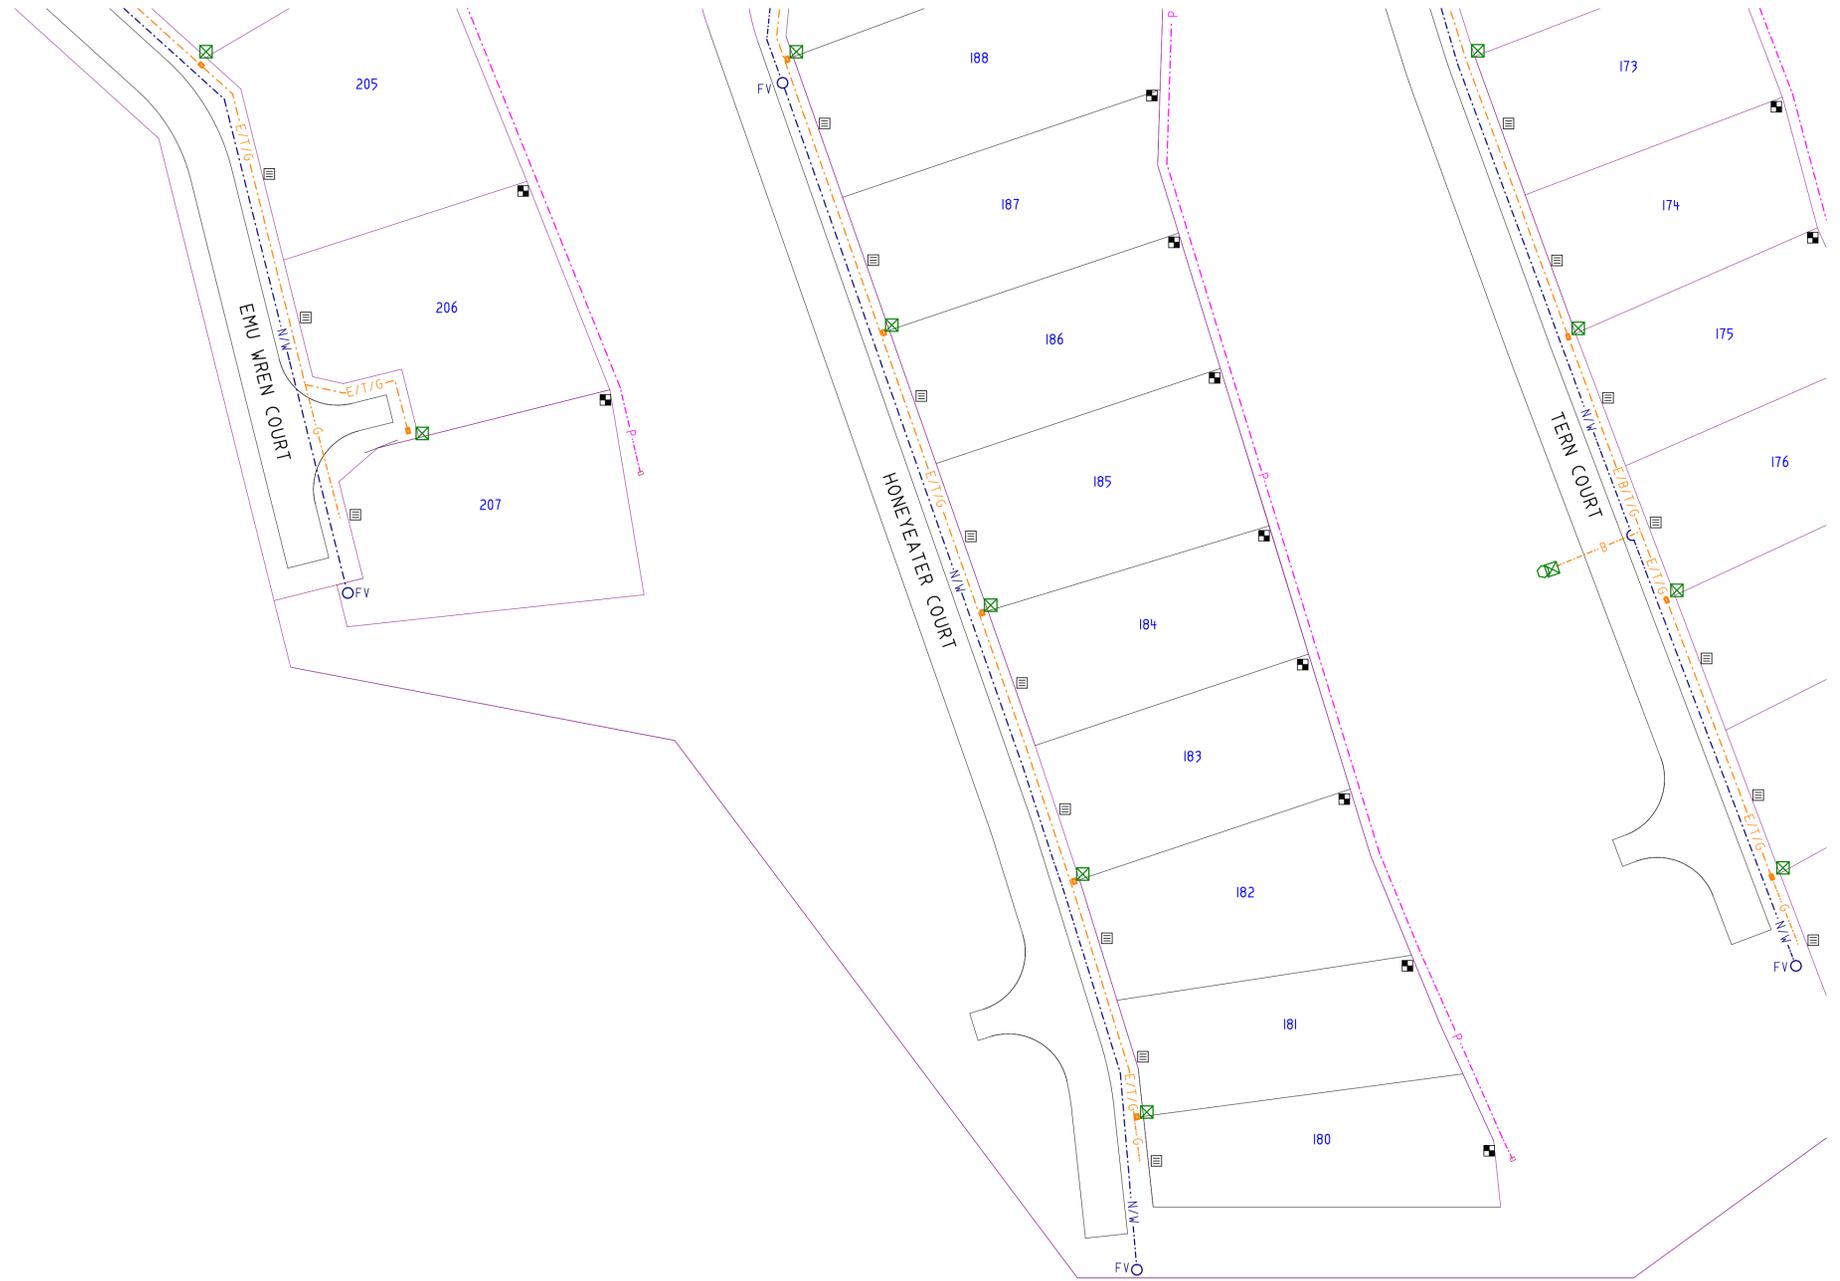

**P.A.DANSIE & ASSOCIATES PTY.LTD.**  
 A.C.N.008 268 335  
**LICENSED SURVEYORS**  
 3 ANGAS STREET 5606 PORT LINCOLN SA  
 REFERENCE: 02326  
 ST1 ASCON 7-2008  
 PH (08) 86826632  
 EMAIL padansie@bigpond.com  
 FAX (08) 86821466

REV.	DATE	DESCRIPTION	CALC	FIELD
ADDITIONS, AMENDMENTS & APPROVALS				

POINT BOSTON PENINSULA  
 AS CONSTRUCTED PLAN STAGE I SUBDIVISION  
 SCALE 0 5 10 20 30 40 50 METRES  
 ISSUE DATE 28th JULY 2008

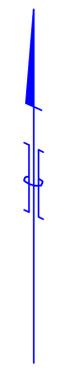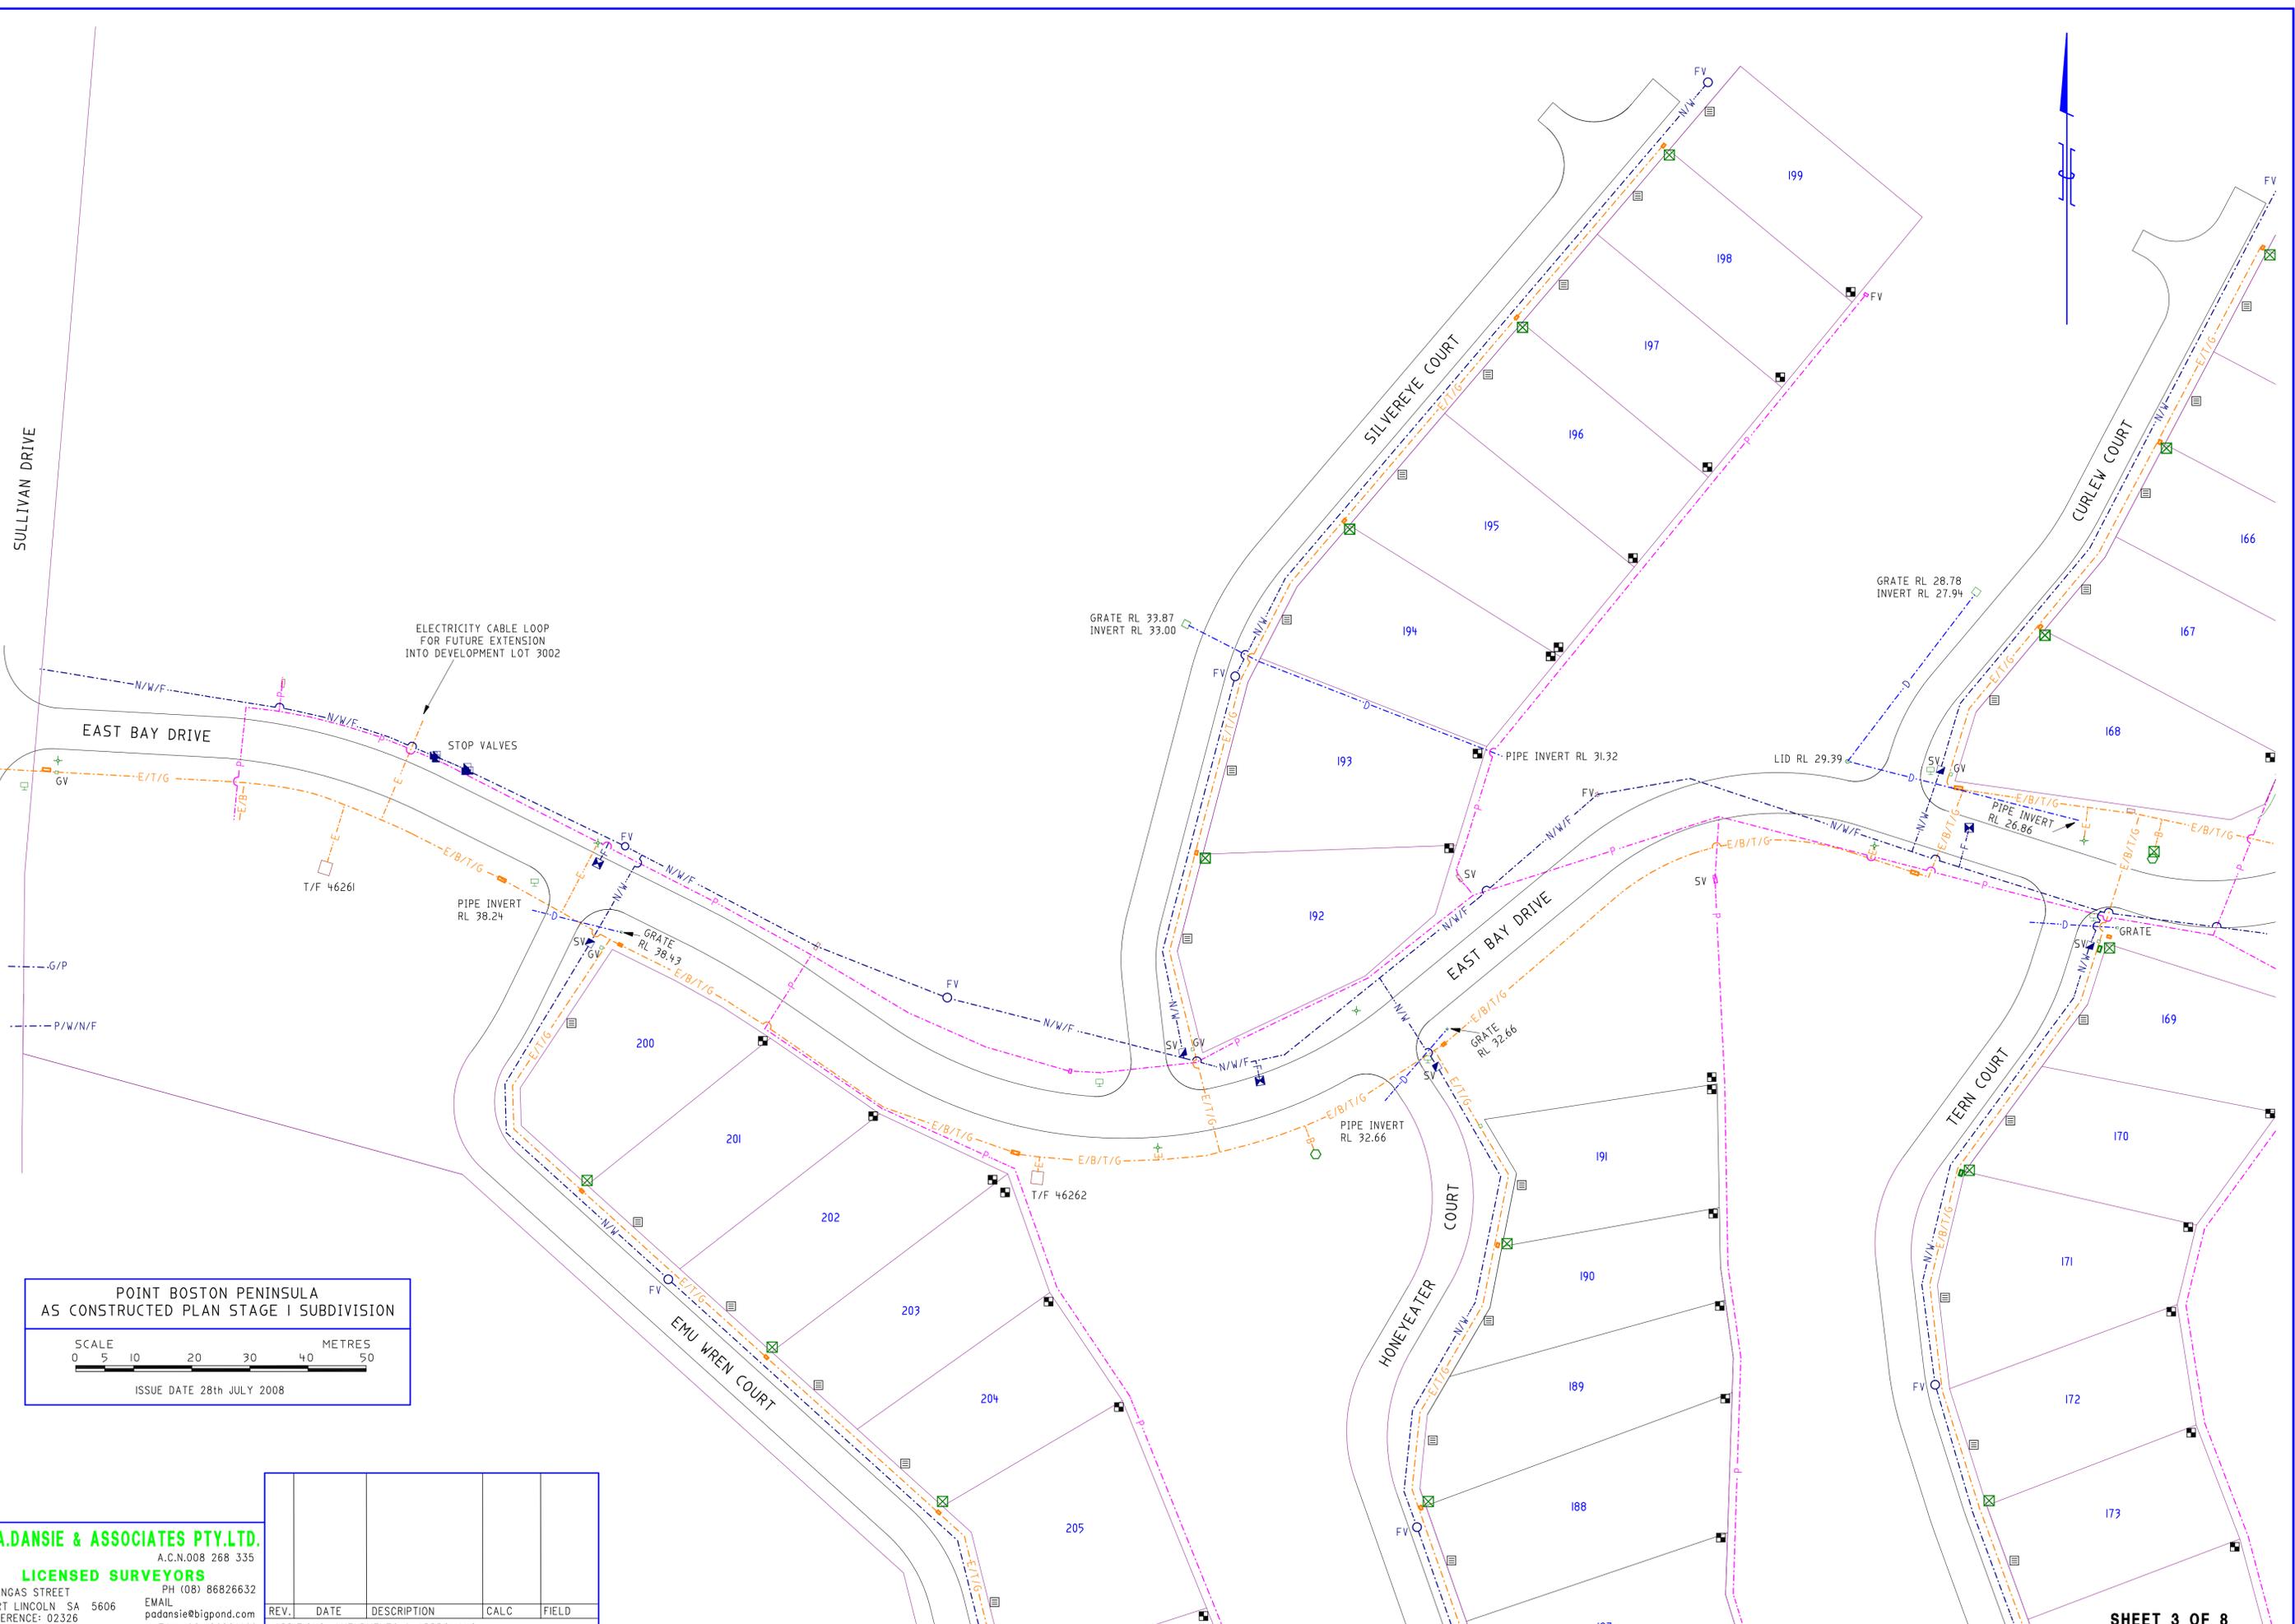


POINT BOSTON PENINSULA  
AS CONSTRUCTED PLAN STAGE I SUBDIVISION

SCALE 0 5 10 20 30 40 50 METRES

ISSUE DATE 28th JULY 2008

**P.A.DANSIE & ASSOCIATES PTY.LTD.**  
A.C.N.008 268 335  
**LICENSED SURVEYORS**  
3 ANGAS STREET PORT LINCOLN SA 5606  
REFERENCE: 02326 ST1 ASCON 7-2008  
PH (08) 86826632  
EMAIL podansie@bigpond.com  
FAX (08) 86821466

REV.	DATE	DESCRIPTION	CALC	FIELD
ADDITIONS, AMENDMENTS & APPROVALS				

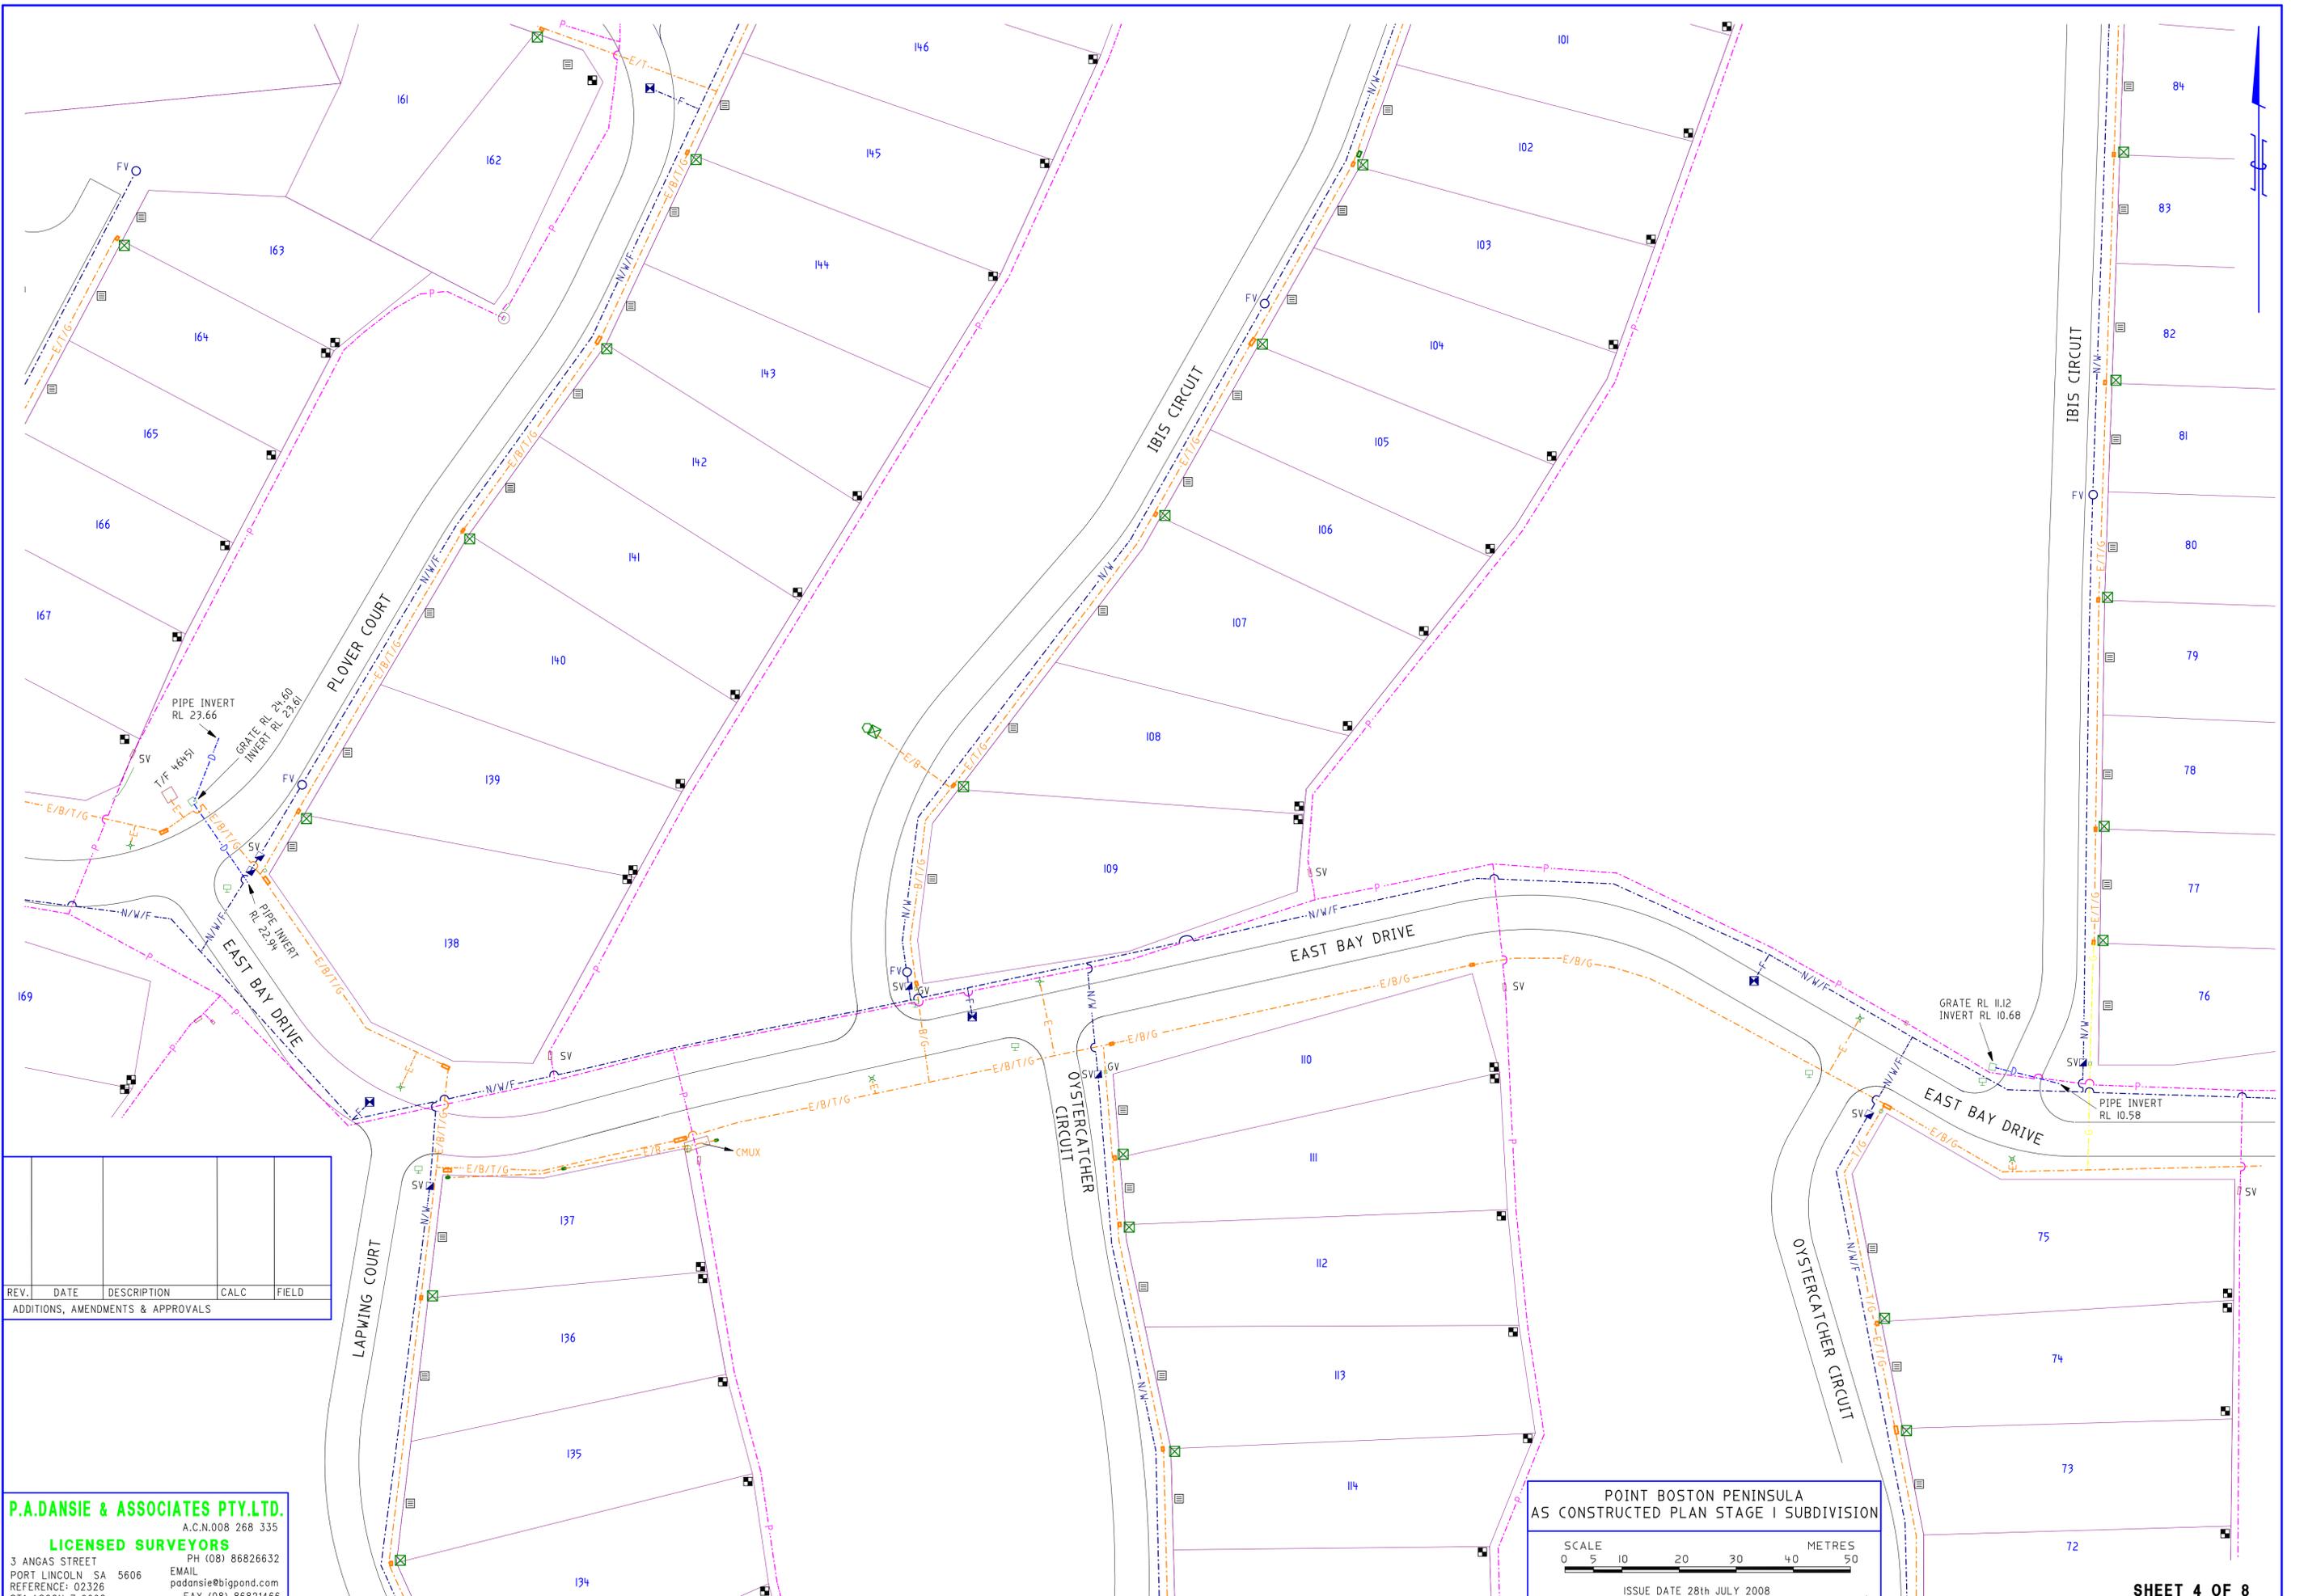

REV.	DATE	DESCRIPTION	CALC	FIELD
ADDITIONS, AMENDMENTS & APPROVALS				

**P.A.DANSIE & ASSOCIATES PTY.LTD.**  
 A.C.N.008 268 335  
**LICENSED SURVEYORS**  
 3 ANGAS STREET PH (08) 86826632  
 PORT LINCOLN SA 5606 EMAIL padansie@bigpond.com  
 REFERENCE: 02326  
 ST1 ASCON 7-2008 FAX (08) 86821466

POINT BOSTON PENINSULA  
 AS CONSTRUCTED PLAN STAGE 1 SUBDIVISION

SCALE 0 5 10 20 30 40 50 METRES


ISSUE DATE 28th JULY 2008

POINT BOSTON PENINSULA  
AS CONSTRUCTED PLAN STAGE I SUBDIVISION


SCALE  
0 5 10 20 30 40 50 METRES

ISSUE DATE 28th JULY 2008

REV.	DATE	DESCRIPTION	CALC	FIELD
ADDITIONS, AMENDMENTS & APPROVALS				

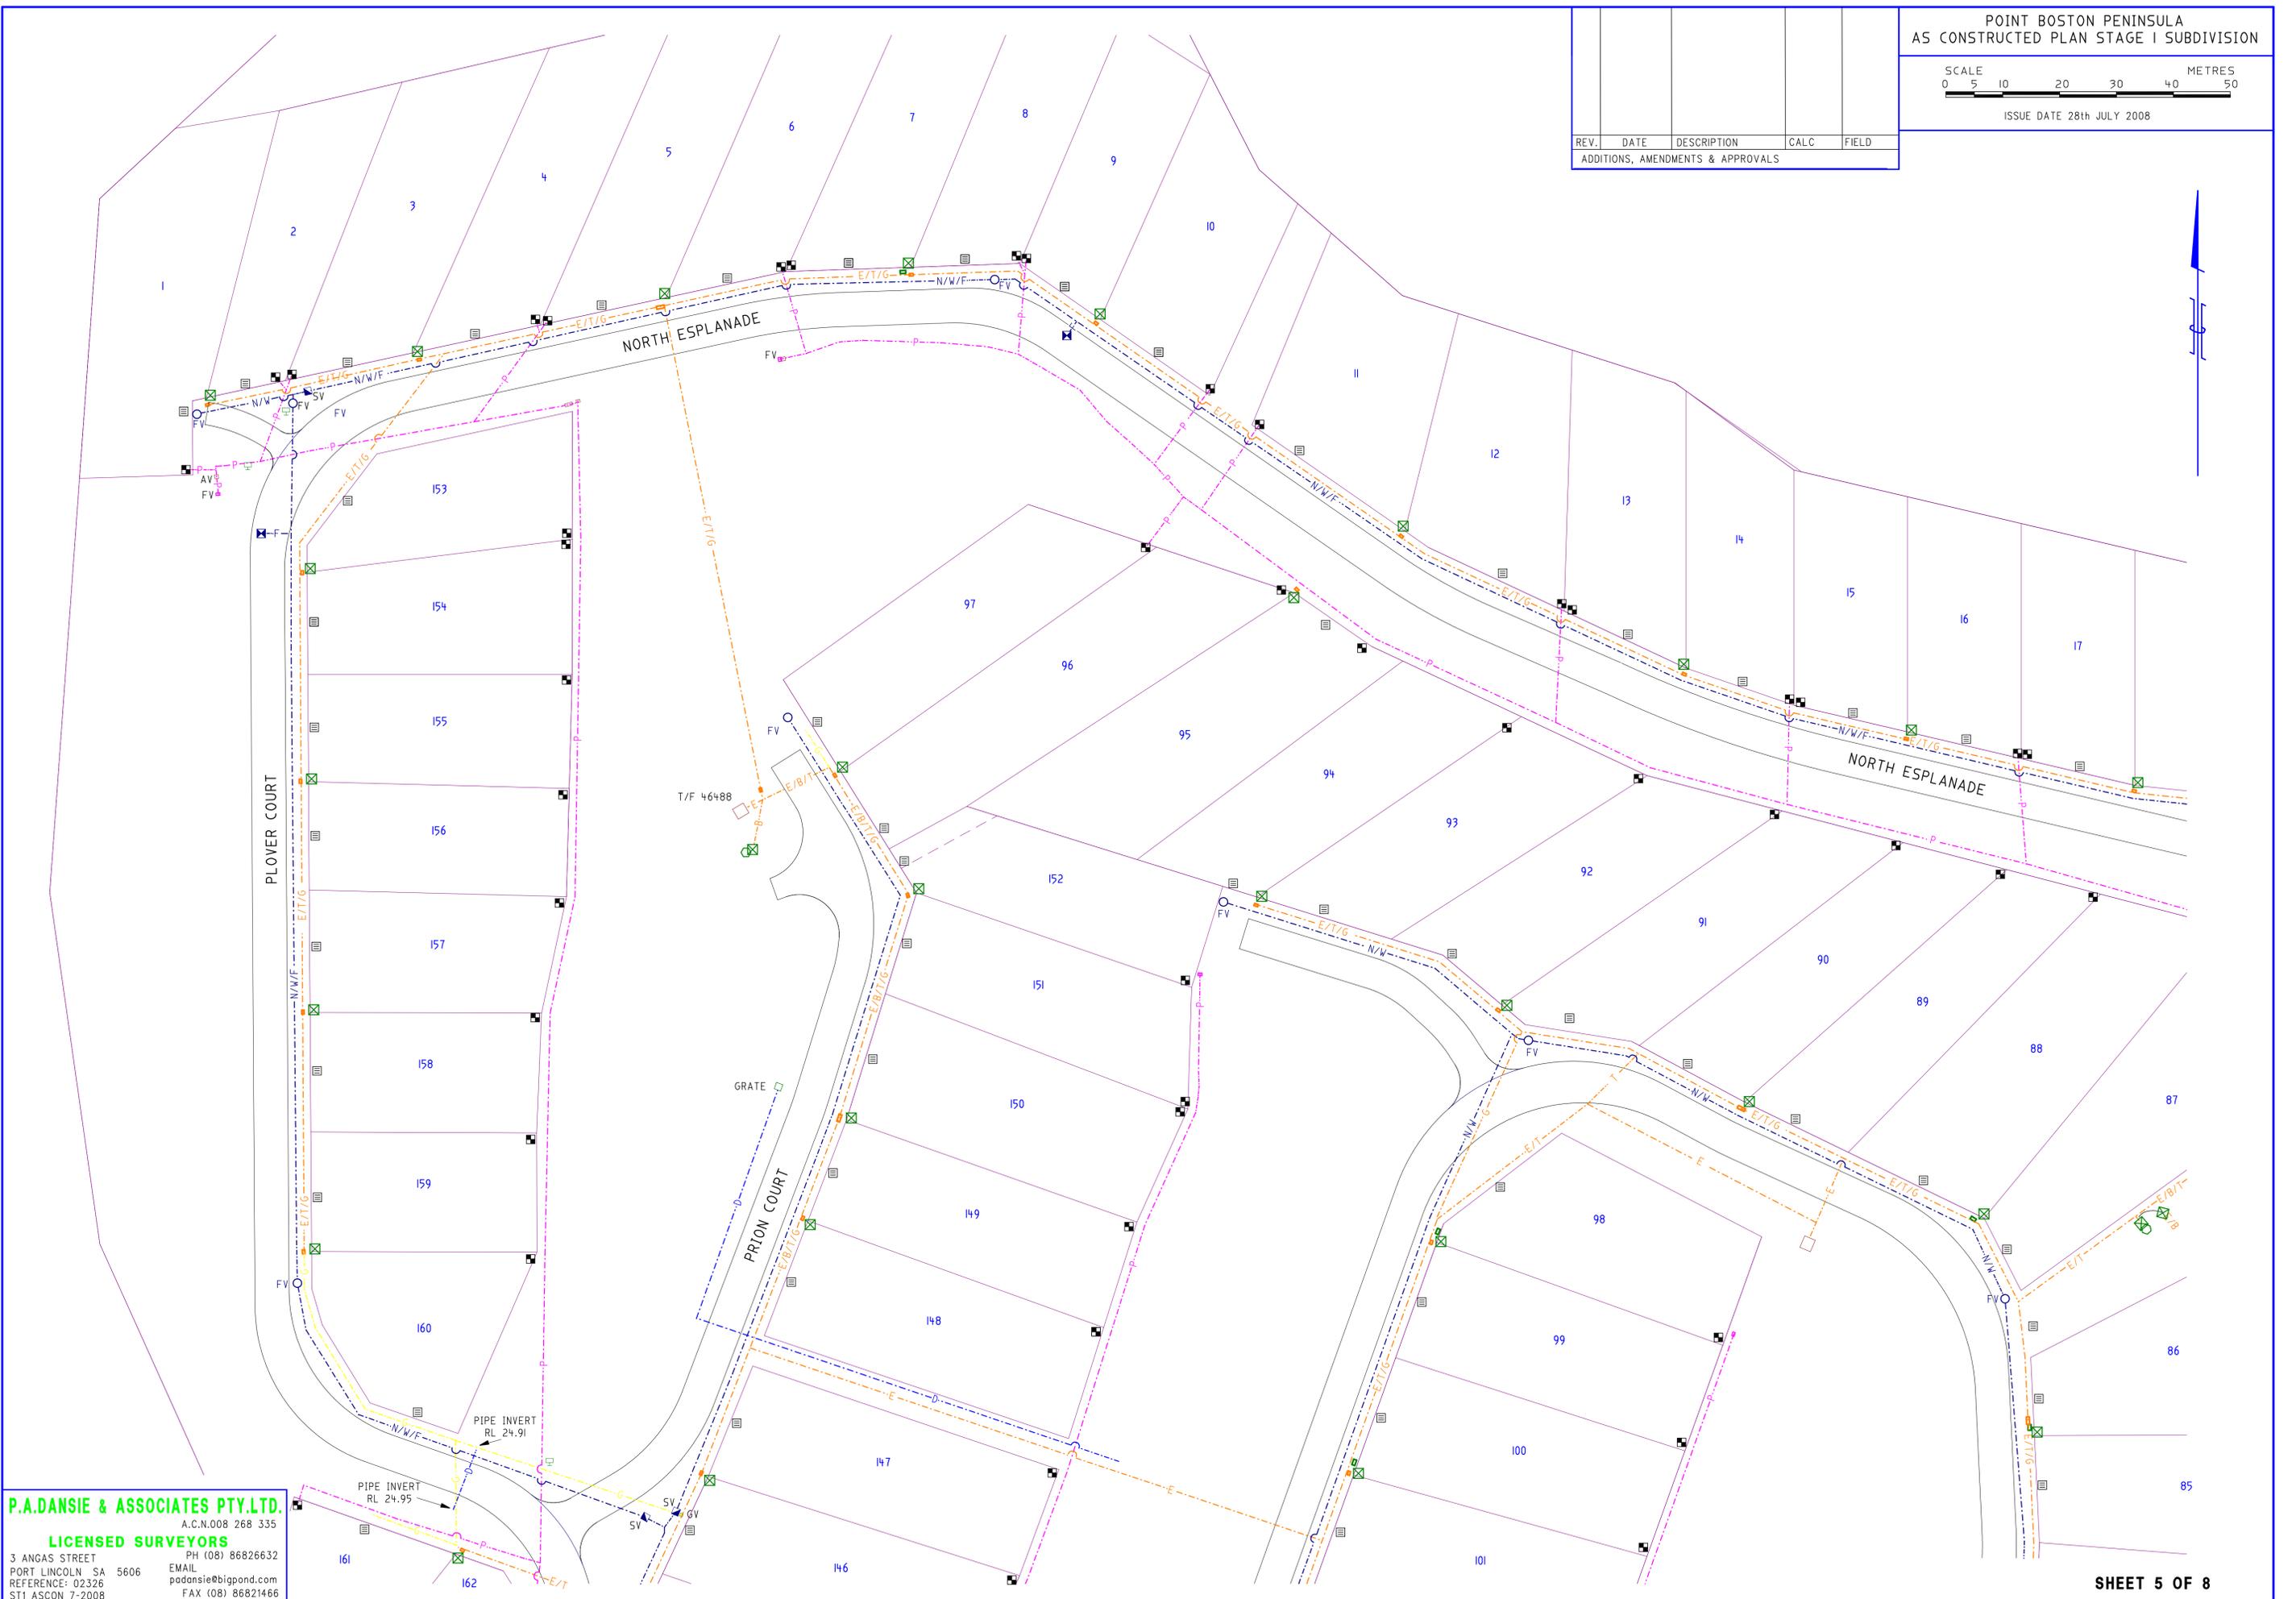

**P.A.DANSIE & ASSOCIATES PTY.LTD.**  
A.C.N.008 268 335  
**LICENSED SURVEYORS**  
3 ANGAS STREET PH (08) 86826632  
PORT LINCOLN SA 5606 EMAIL padansie@bigpond.com  
REFERENCE: 02326  
ST1 ASCON 7-2008 FAX (08) 86821466

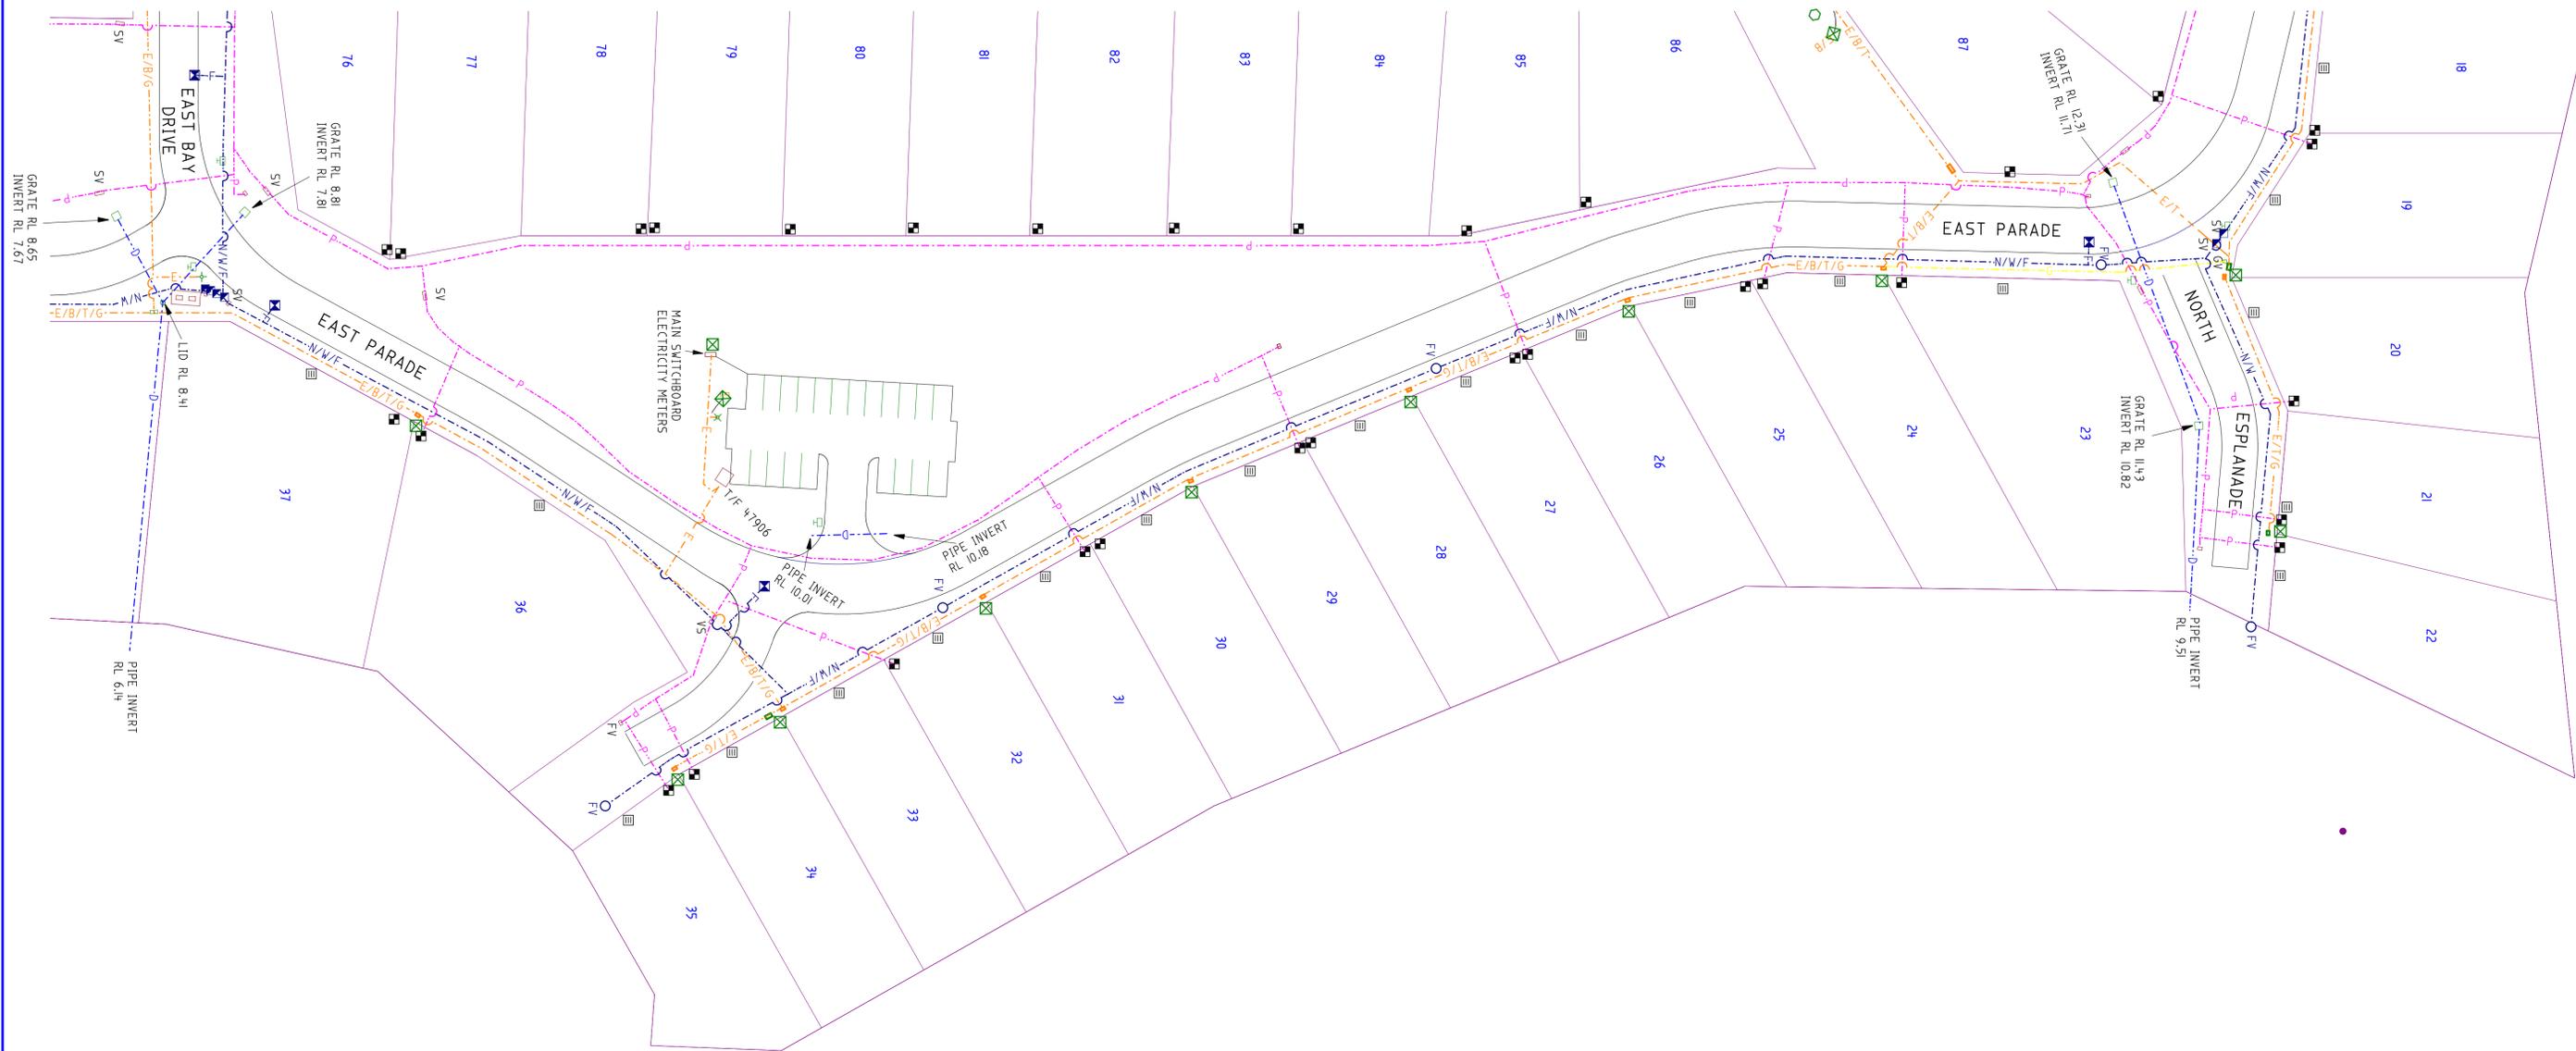


**P.A.DANSIE & ASSOCIATES PTY.LTD.**  
 A.C.N.008 268 335  
**LICENSED SURVEYORS**  
 3 ANGAS STREET PH (08) 86826632  
 PORT LINCOLN SA 5606 EMAIL padansie@bigpond.com  
 REFERENCE: 02326 FAX (08) 86821466  
 ST1 ASCON 7-2008

REV.	DATE	DESCRIPTION	CALC	FIELD
ADDITIONS, AMENDMENTS & APPROVALS				

POINT BOSTON PENINSULA  
 AS CONSTRUCTED PLAN STAGE I SUBDIVISION

SCALE  
 0 5 10 20 30 40 50 METRES

ISSUE DATE 28th JULY 2008

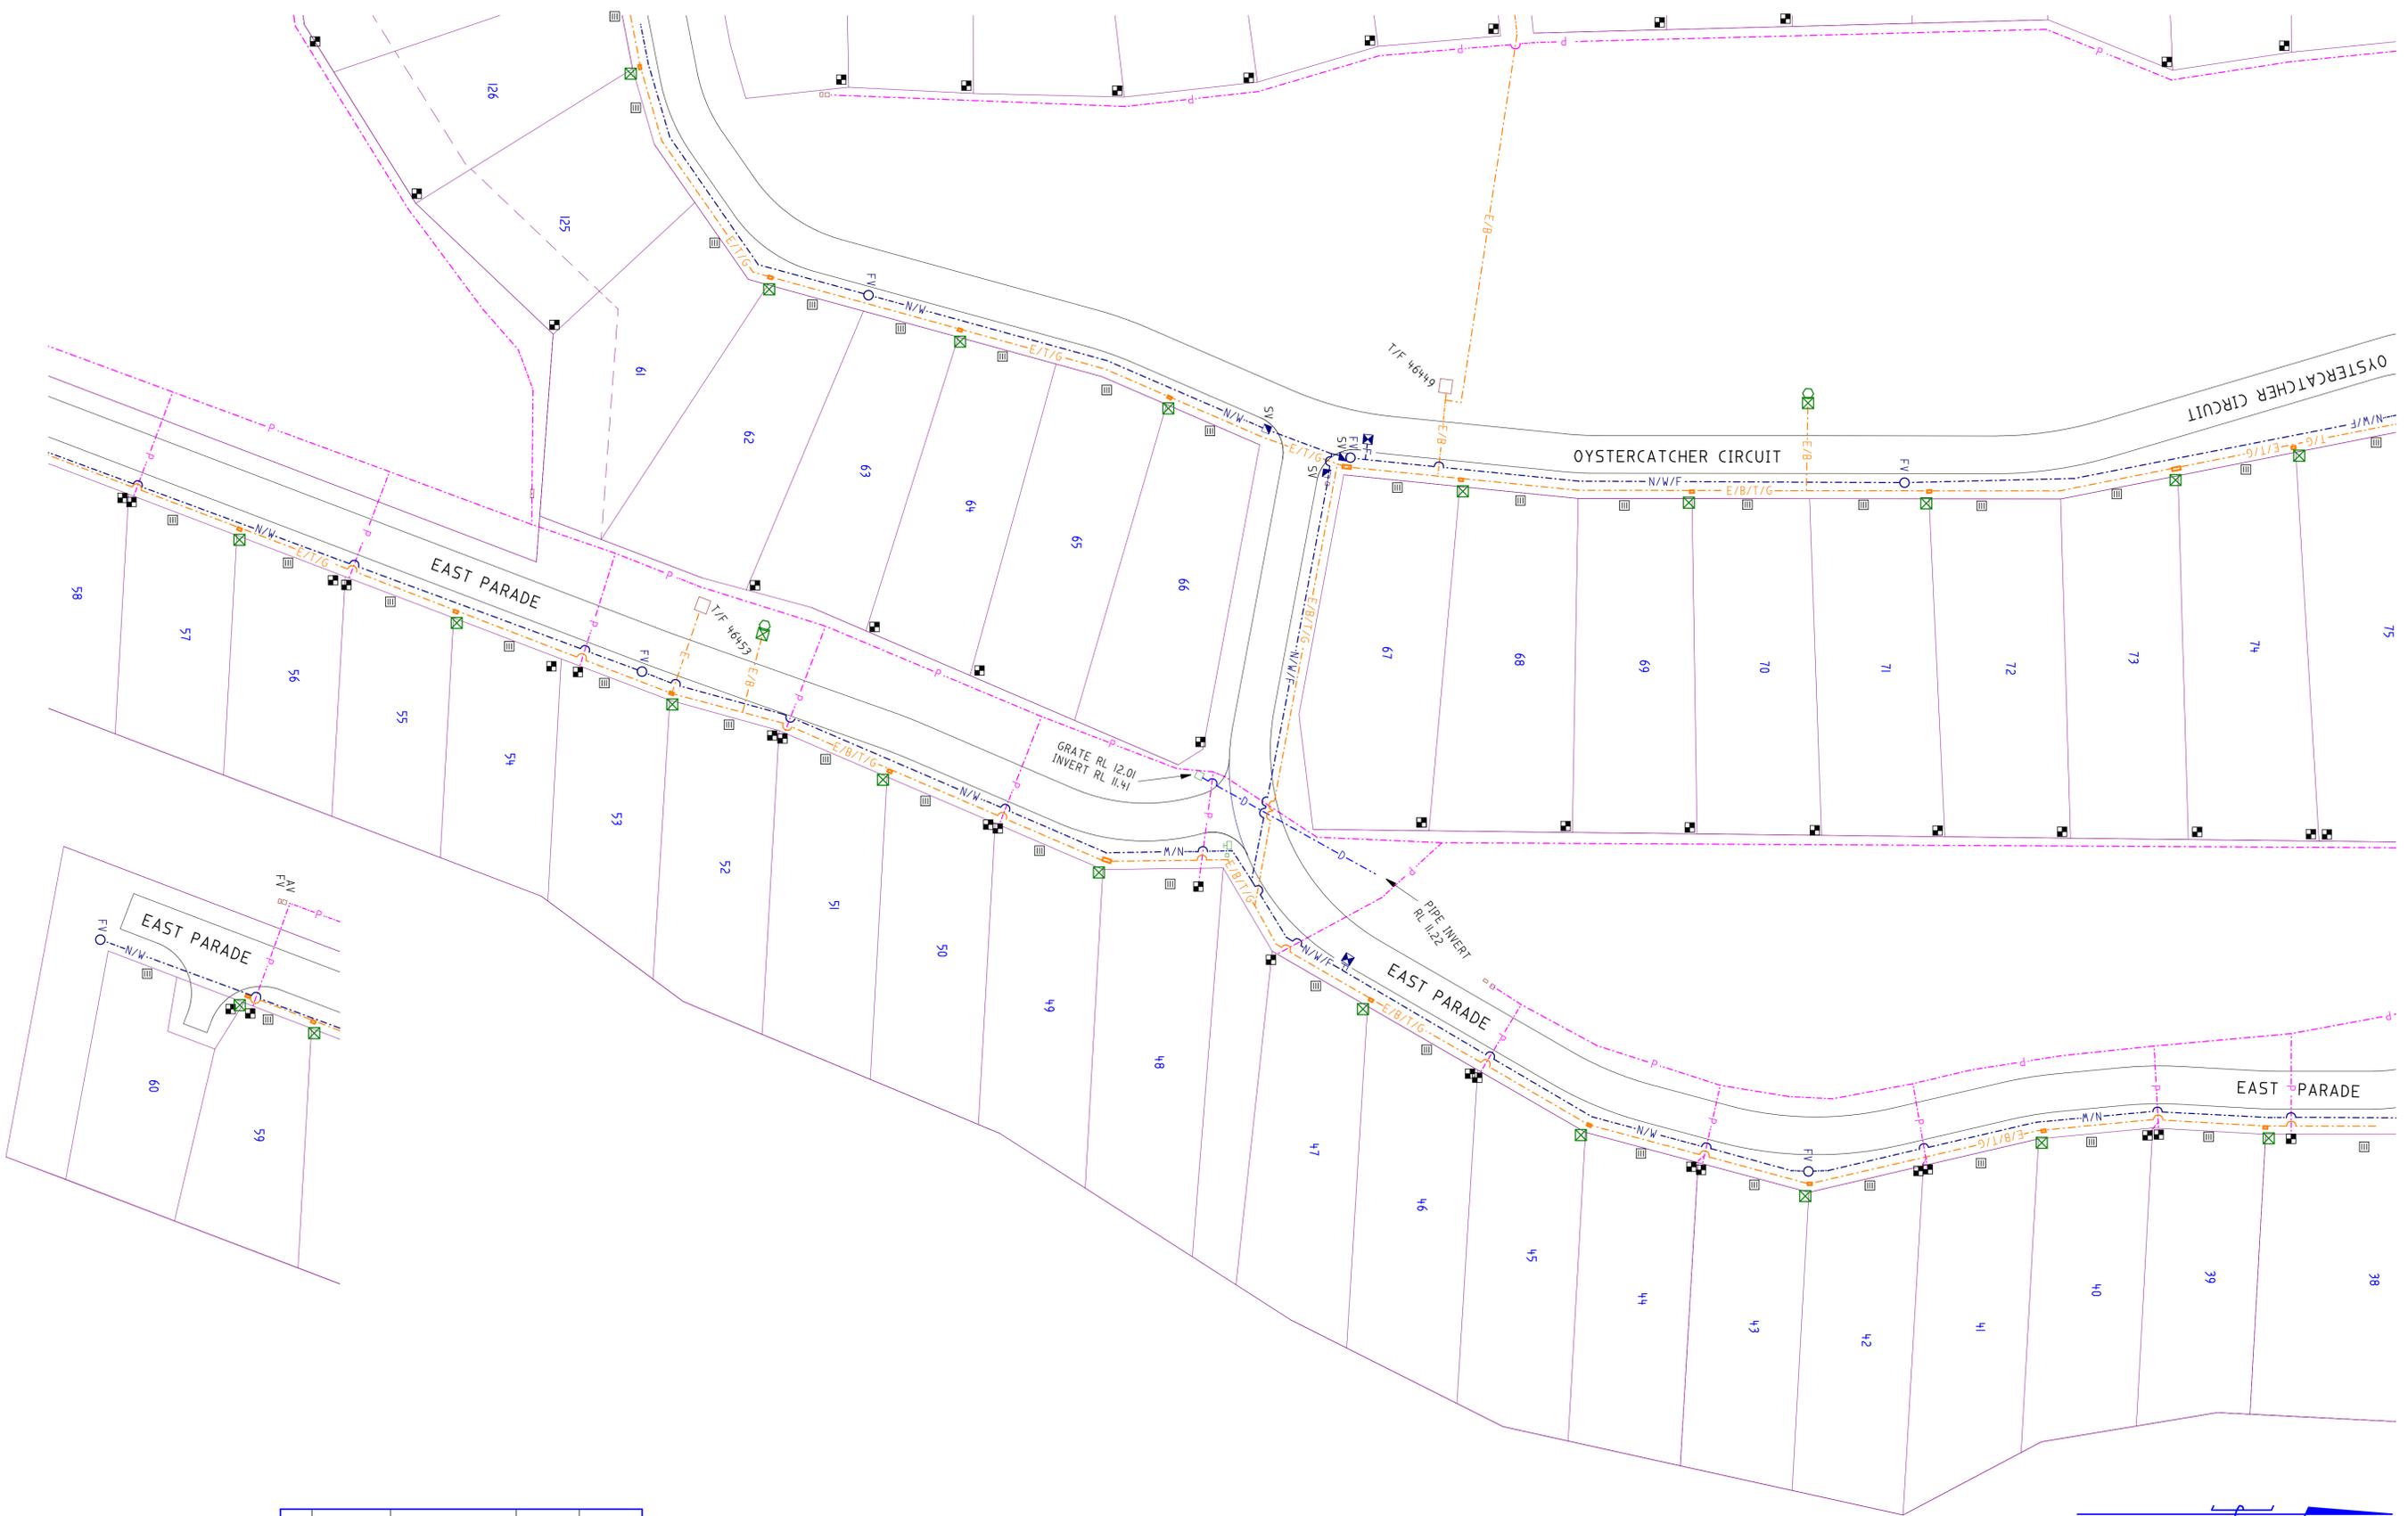

**P.A.DANSIE & ASSOCIATES PTY.LTD.**  
 A.C.N.008 268 335  
**LICENSED SURVEYORS**  
 3 ANGAS STREET PH (08) 86826632  
 PORT LINCOLN SA 5606 EMAIL podansie@bigpond.com  
 REFERENCE: 02326 FAX (08) 86821466  
 ST11 ASCON 7-2008

REV.	DATE	DESCRIPTION	CALC	FIELD
ADDITIONS, AMENDMENTS & APPROVALS				

POINT BOSTON PENINSULA  
 AS CONSTRUCTED PLAN STAGE I SUBDIVISION

SCALE 0 5 10 20 30 40 50 METRES

ISSUE DATE 28th JULY 2008

**P.A.DANSIE & ASSOCIATES PTY.LTD.**  
 A.C.N.008 268 335  
**LICENSED SURVEYORS**  
 3 ANGAS STREET PH (08) 86826632  
 PORT LINCOLN SA 5606 EMAIL padansie@bigpond.com  
 REFERENCE: 02326 FAX (08) 86821466  
 ST1 ASCON 7-2008

REV.	DATE	DESCRIPTION	CALC	FIELD
ADDITIONS, AMENDMENTS & APPROVALS				

POINT BOSTON PENINSULA  
 AS CONSTRUCTED PLAN STAGE I SUBDIVISION

SCALE  
 0 5 10 20 30 40 50 METRES

ISSUE DATE 28th JULY 2008

